

Myers Surveying Company, Inc.

2740 East Main Street, Columbus 43209 (Bexley), Ohio
 614-235-8677 FAX: 614-235-4559


A Boundary Survey prepared for and certified to:
TitlePro & Joshua D. Eversole

Legal Description: Situated in Ohio, County of Franklin, Township of Truro, Being 1.526 Acres located in Half Section 6,
 Township 16, Range 20, Refugee Lands

Applicant:

Posted Address: 455 Waggoner Road, Reynoldsburg, Ohio

Apparent Encroachments: House in easement.

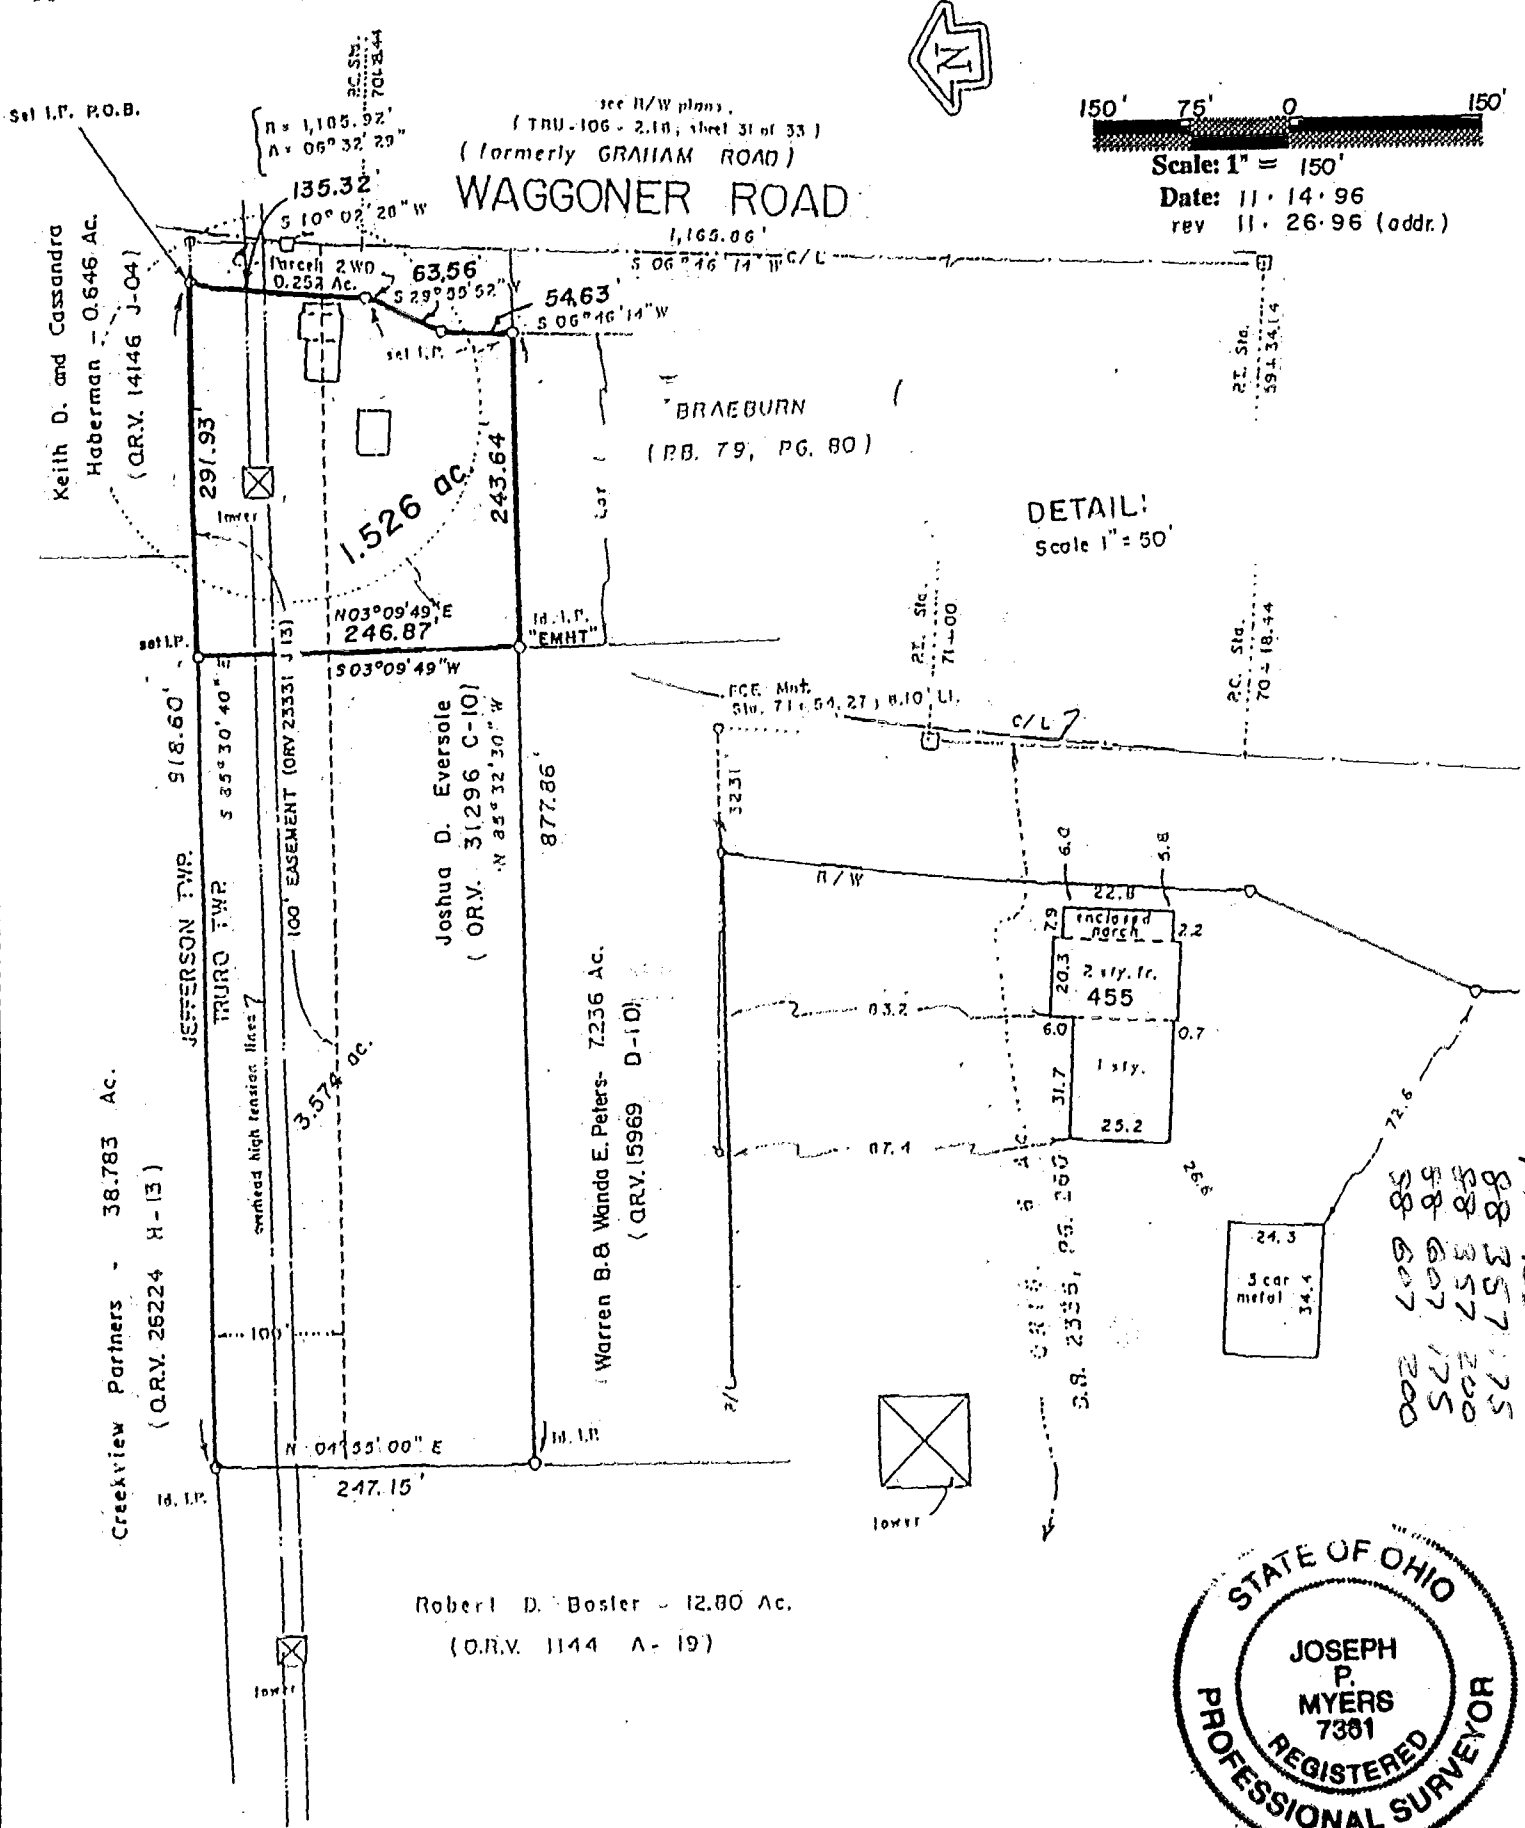

We hereby certify that the foregoing Boundary Survey was prepared from actual field measurements in accordance with Chapter 4733-37 Ohio Administrative Code. Iron pins set are 30"x1" O.D. with an orange plastic plug inscribed "P.S. 6579", unless otherwise noted. Basis of bearing is the centerline of Waggoner Road held as North 06 degrees 46 minutes 14 seconds East

Myers Surveying Co., Inc.

By *Joseph P. Myers*
 Professional Surveyor