

ENG-OFF

1953 7150

MYERS SURVEYING Co.

2740 East Main Street, Columbus 43209 (Bexley), Ohio

LOTS 488, 489, 490, & PART OF LOT 487, LINCOLN PARK, COLUMBUS, OHIO
FOR
CHICAGO TITLE INS. CO.
And/or
STATE SAVINGS BANK

P.B. 7 Page 430
Scale 1"=20'

Franklin Co. Rec. Office


4-28-'88

Revised 5-6-'88
(Lot splits)

Rev. 7-25-'88 (Title Co. & Lender added)

PLYMOUTH AVE. 50'


129.50'

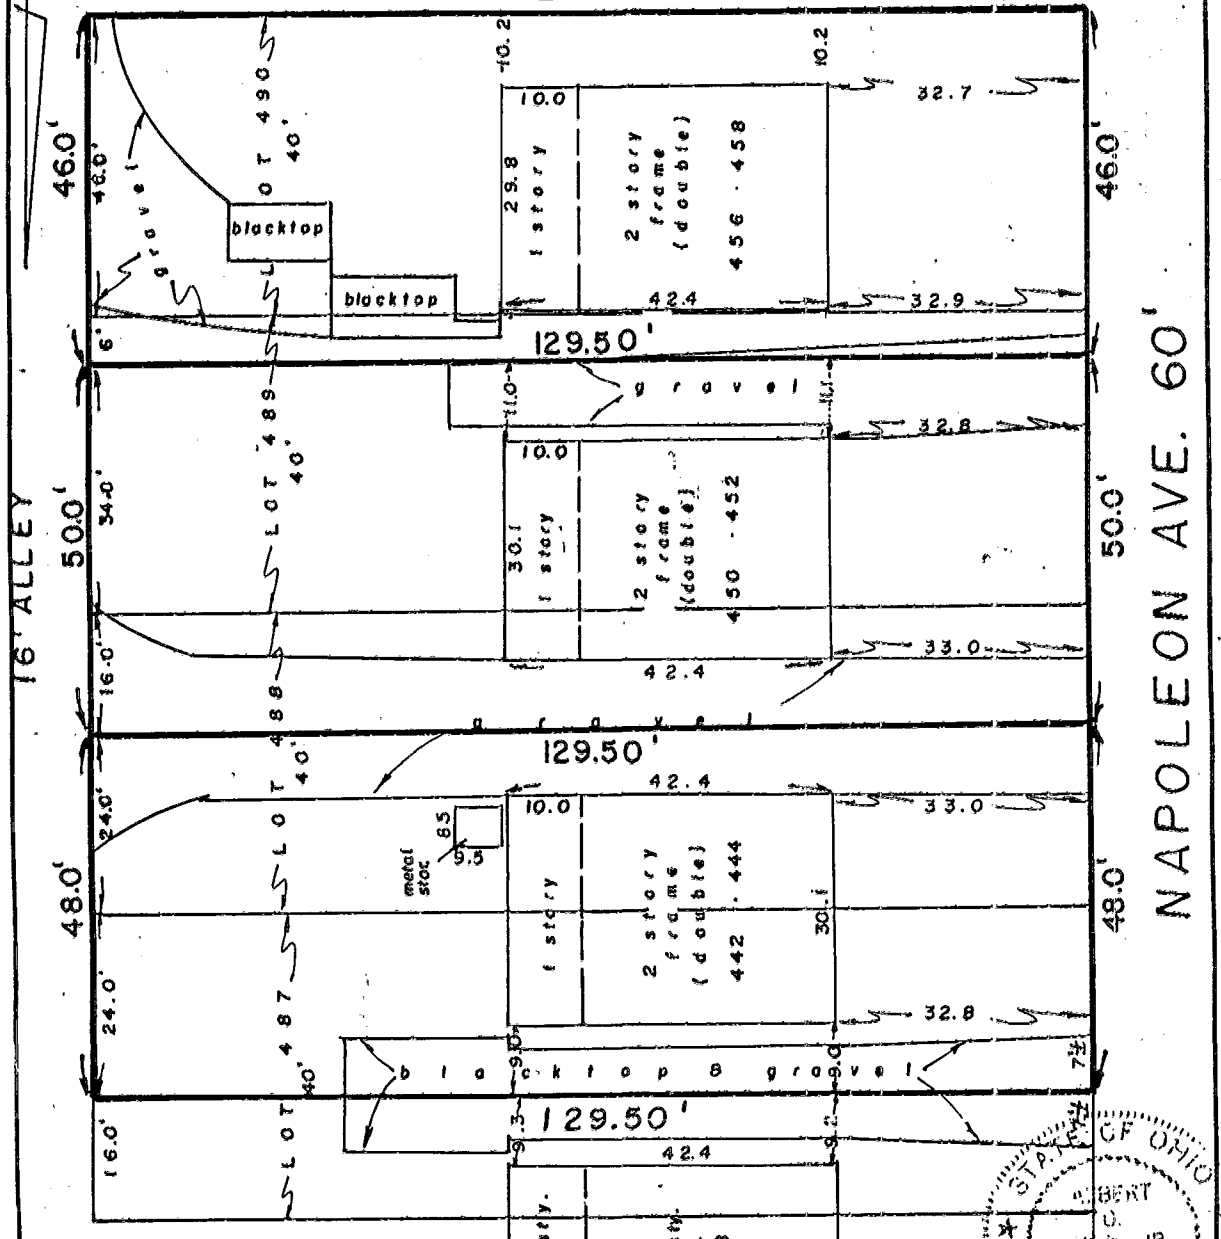

NOT TO BE USED TO ERECT FENCES

We hereby certify that the foregoing plat was prepared from an actual survey of the premises. No side line of principal building is less than dimension shown. Iron pins not set unless indicated thus -O-. For Mortgage Loan & Title Insurance purposes only.

MYERS SURVEYING CO.
Robert Myers, Jr.
Registered Surveyor

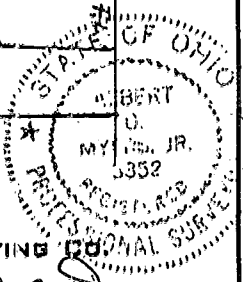

74 (75) (76) 4-28-88

50-14