

Myers Surveying Company, Inc.


2740 East Main Street, Columbus 43209 (Bexley), Ohio
614-235-8677 FAX: 614-235-4559

A Boundary Survey prepared for and certified to:
Knolls Realty and/or Dave & Moscey Cooper

Legal Description: Situated in Ohio, County of Franklin, City of Whitehall, Being Lots 18 and 19 Blower Addition, Plat Book 17, Page 268

Applicant: Dave & Moscey Cooper

Posted Address: 687 Beechwood Ave., Whitehall, Ohio

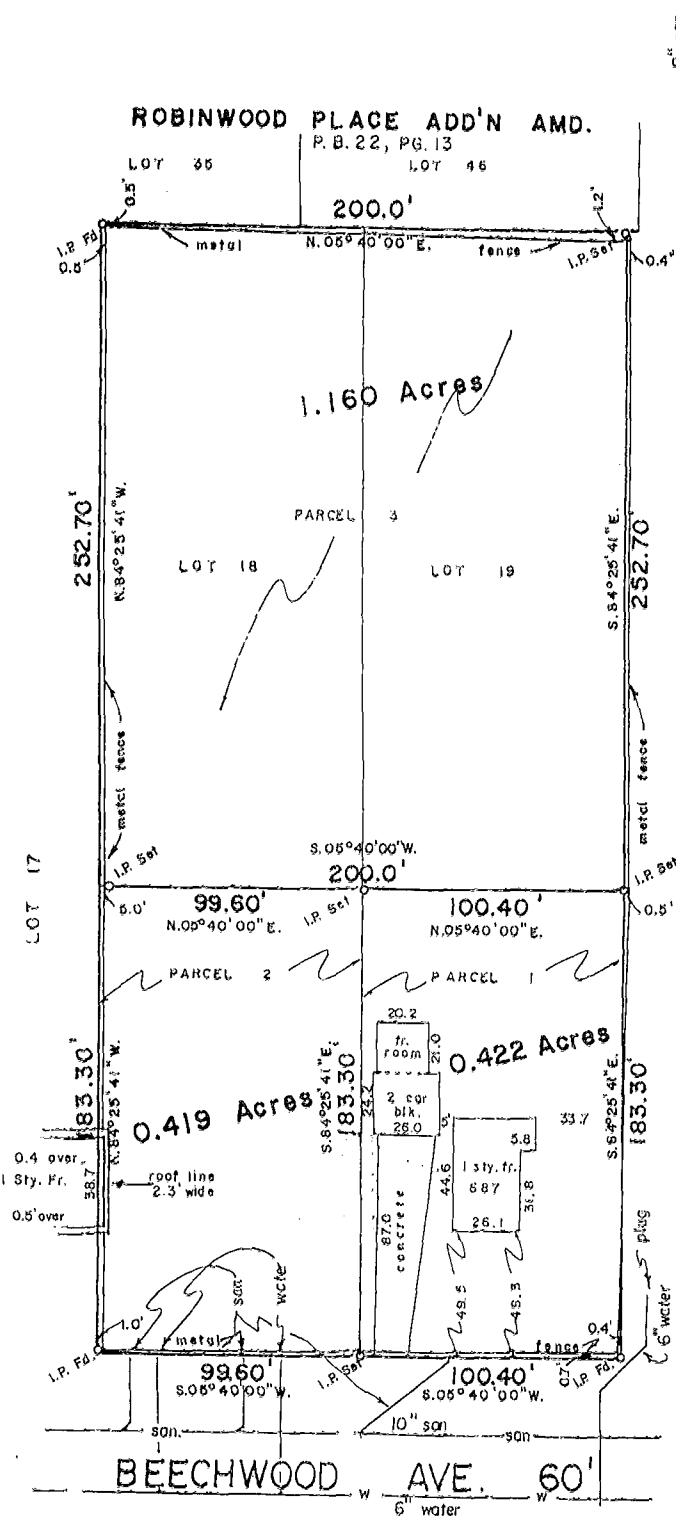

60' 30' 0' 60'

Scale: 1" = 60'

Date: 1-26-98

rev. 2-18-98 (loc. san/water per plan info. only)

rev. 3-26-98 (lot split)

rev. 5-4-98 (lot no.)



WASHBURN ST. 50'

Lot Split Authorized
NO PLAT REQUIRED

Board of Zoning & Blg. Appeals
CITY OF WHITEHALL, OHIO

By *Robert J. Mann*
(Chairman)

Date: 5-27-98

We hereby certify that the foregoing Boundary Survey was prepared from actual field measurements in accordance with Chapter 4733-37 Ohio Administrative Code. Iron pins set are 30"x1" O.D. with an orange plastic plug inscribed "P.S. 6579", unless otherwise noted. Basis of bearing is the west line of Beechwood Avenue as South 03 degrees 40 minutes 00 seconds West per Plat Book 17, Page 268



Myers Surveying Co., Inc.

By *Paul T. Dinan*
Professional Surveyor

85607125

85607125