MYERS SURVEYING CO.

2740 East Main Street, Columbus 43209 (Bexley), Ohio

PARTITION OF A TRACT CONVEYED TO F. M. CRIST
OF RECORD IN D.B. 2423, PG. 487, BEXLEY, OHIO
FOR

ESTATE OF CLYDE L. & FANNIE CRIST

D.B. 2423 Page 487
Scale 1"=30'

Franklin Co. Rec. Office
11-8-'80

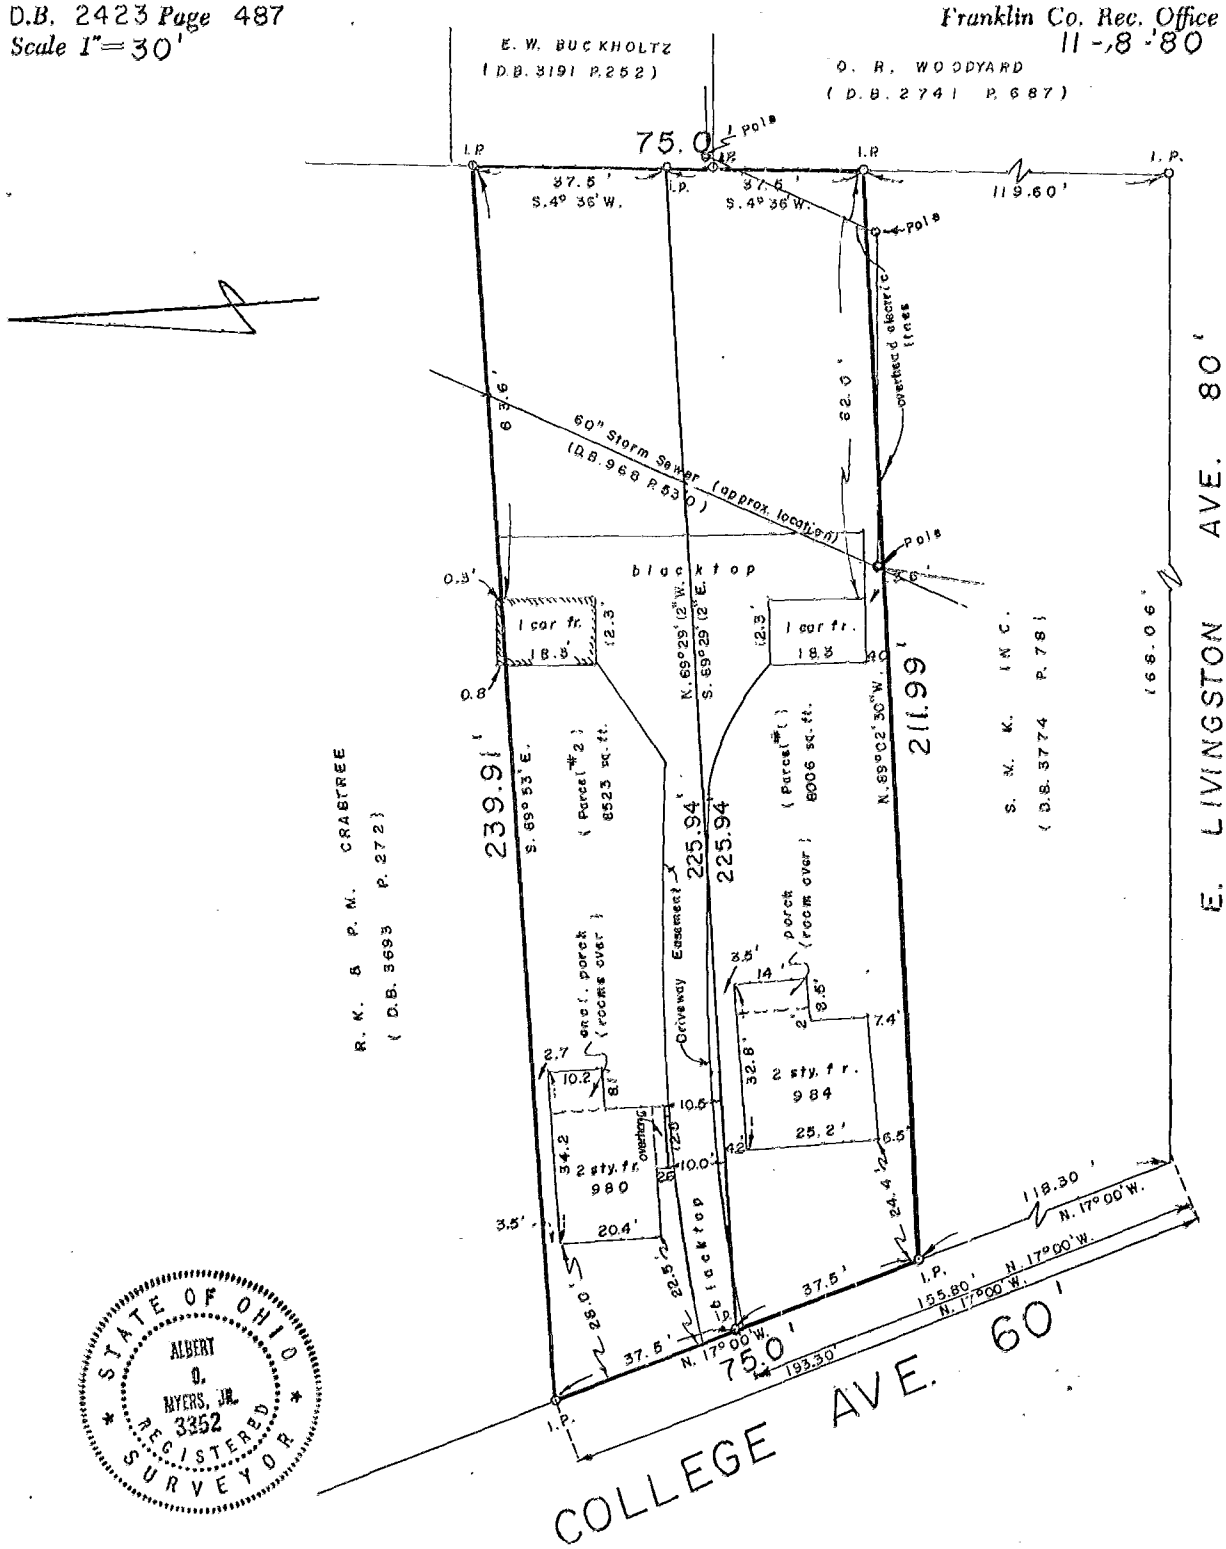

We hereby certify that the foregoing plat was prepared from an actual survey of the premises. No side line of principal building is less than dimension shown. Iron pins not set unless indicated thus –0–.

MYERS SURVEYING CO.
BY [signature]
Registered Surveyor

HILLS CO. 2M #1000H
1-11-7-80

F	D	L	C
[illegible]	[illegible]		