


0-152-D  
TRURO Twp

# LOT SPLIT EXHIBIT



Situated in the State of Ohio, County of Franklin, City of Whitehall, located in Section 16, Township 12, Range 21, Refugee Land, being a 1.130 acres tract out of those tracts of land as described in a deed to Santo Del Matto Jr., of record, in Deed Book 3333 Page 384. All references herein are to records found in the recorder's Office, Franklin County, Ohio.

Bearings herein are based on those of record on Deed Book 3333, Page 384.

This exhibit was prepared based on an actual field survey of the premises performed on July 1999.

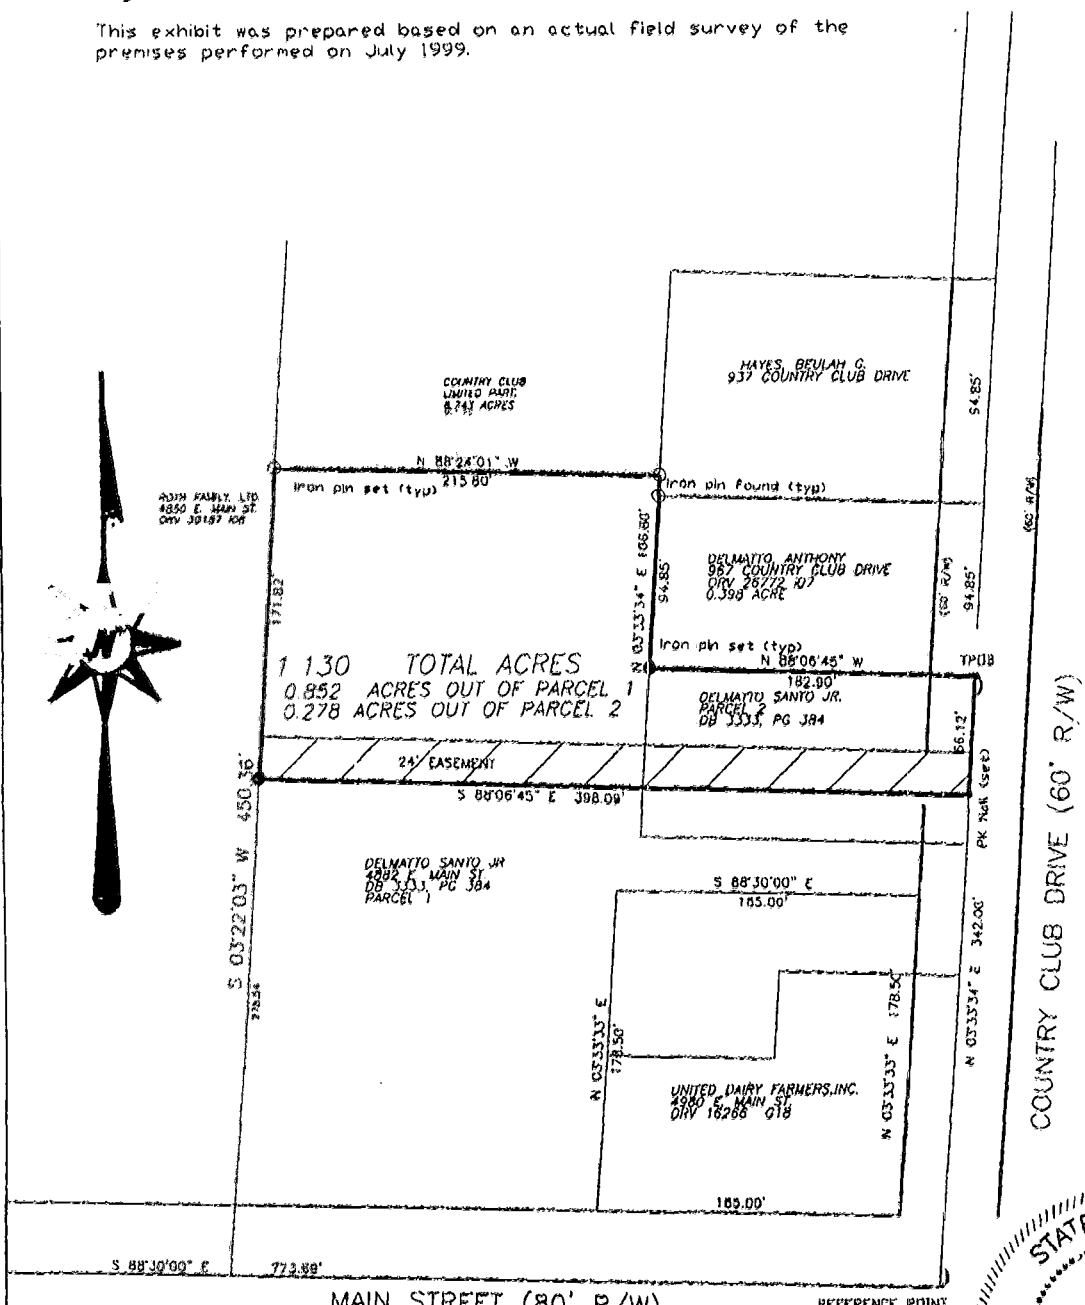

1.130 TOTAL ACRES  
0.852 ACRES OUT OF PARCEL 1  
0.278 ACRES OUT OF PARCEL 2

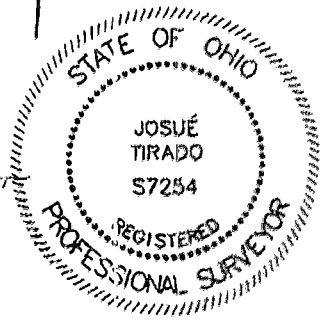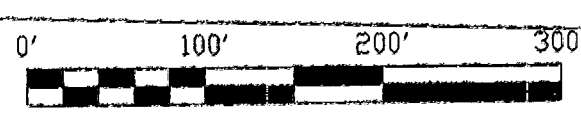

REGISTERED PROFESSIONAL SURVEYOR		JOSUE TIRADO	No. 57254	DATE 9-08-99
PROJECT Country Club Road	JOB NO. 9946		<b>A TO Z</b> SURVEYING AND INFORMATION CO. THE SOLUTION TO YOUR SURVEYING NEEDS.	
SUBJECT SPLIT EXHIBIT	REVISION 9-29-99			
SURVEYED BY JOSUE	DRAWN BY JOSUE	CHECKED		

86357125

EXHIBIT  
B