


186357150 N-129-A

COLUMBUS COUNTRY CLUB ROAD

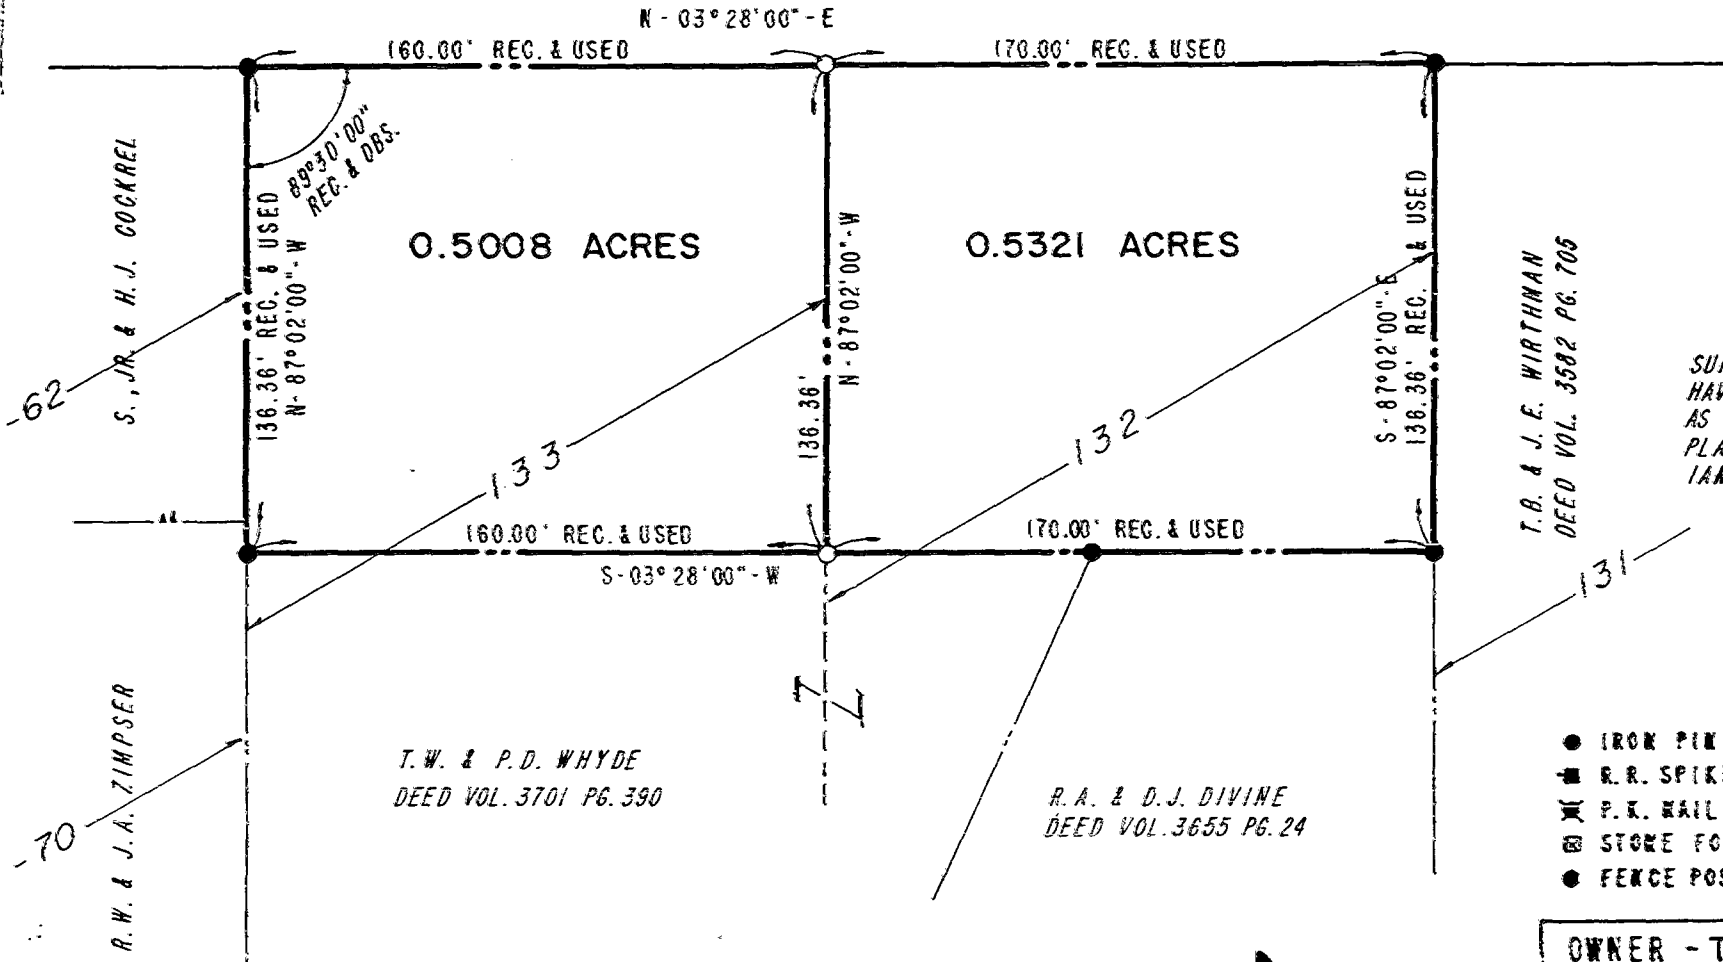

I HEREBY CERTIFY THAT I HAVE SURVEYED THE LAND SHOWN ON THIS PLAT AND HAVE FOUND OR SET THE PINS AND MONUMENTS AS SHOWN HEREON. BEARINGS USED ON THIS PLAT ARE REFERRED TO AN ASSUMED MERIDIAN AND ARE USED TO DENOTE ANGLES ONLY.



JAMES R. BOCK, P.S.
REG. SURVEYOR No. 6051

- IRON PIN FOUND
- R.R. SPIKE FOUND
- ⊗ P.K. NAIL FOUND
- ⊕ STONE FOUND
- FENCE POST FD. & USED
- 5" X 30" IRON PIN SET
- R.R. SPIKE SET
- ⊗ P.K. NAIL SET
- △ BREAK POINT
- x— FENCE LINE

OWNER - TONY & ZORA VUTICEVSKI

STATE OF OHIO, COUNTY OF FRANKLIN,
CITY OF WHITEHALL, PART OF LOTS 132 &
133 OF 'THE FAIRWAY No. 2', PLAT BK.19 PG.12
DATE - SEPT. 19, 1988 PROJ. No. 88236



SCALE 1" = 50'

BOCK & CLARK
 CONSULTING ENGINEERS & SURVEYORS
 537 N. CLEVELAND - MASSILLON ROAD
 AKRON, OHIO 44313
 666 7576 AKRON
 800-362-8996 ALL OHIO