


87607125
87607100

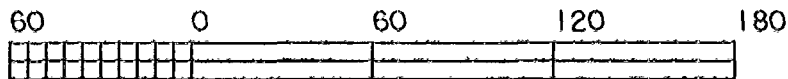

GRAPHIC SCALE - FEET

Basis of Bearings: West line of Lot 1
an arbitrary bearing of N 04°57'10" E"

J. Evan Williams, Family Trust
Inst. No. 200110123236384

Stonegate III
OR 10621 B 17

Holzer Wollam Southeast
OR 8905 A 04

Han-Lar Ltd.
Inst. No. 2000020800207048
Inst. No. 200001270018813



P.O.B. IP Set S 85°31'26"E 100.00' IP Fd

Area:
0.4459 Ac.

H 6500

H 6504

H 6502

Ingress/Egress (Ex. Driveway)
456.82'

N 04°57'10"E

317.08'

S 04°57'10"W

344.42'

S 18°19'28"E

36.08'

40.00'

S 89°41'00" W

S 04°57'10"W 104.00'

448.42'

S 04°57'10"W

IP Fd

100.42'

J. Evan Williams, Family Trust
Inst. No. 200110123236384

Weiberg's Rose Hill
Amended Addition
P.B. 17, Pg. 237



2

3

C/L East Main St.

TO ALL PARTIES INTERESTED IN TITLE TO THE PREMISES SURVEYED:
I do hereby state that this is a true and accurate survey made by me or under my supervision, and that all points are as called, and that there are no encroachments either way across any line except as shown.

Larry B. Felts

Date 11-30-01

Plat of Survey -- 0.4459 Acres


Pt Lot 1, Weiberg's Rose Hill Amended Add'n @ 6500 E, Main St.

FOR: Phil Key

Reynoldsburg, Ohio

OR 5610 E 10
P.B. 17 Pg. 237
Scale: 1" = 60'
Date: 11-27-01
Drawn By: LBF

Ahlers, Moe & Associates, Inc.
Engineering & Surveying
 360 West Waterloo St. P.O. Box 2
 Canal Winchester, Ohio 43110
 (614) 837-1178 Fax: (614) 837-8458

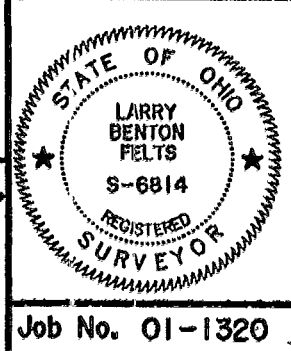

0-1066-0
TRURO Twp