O-1057A
1876 7050

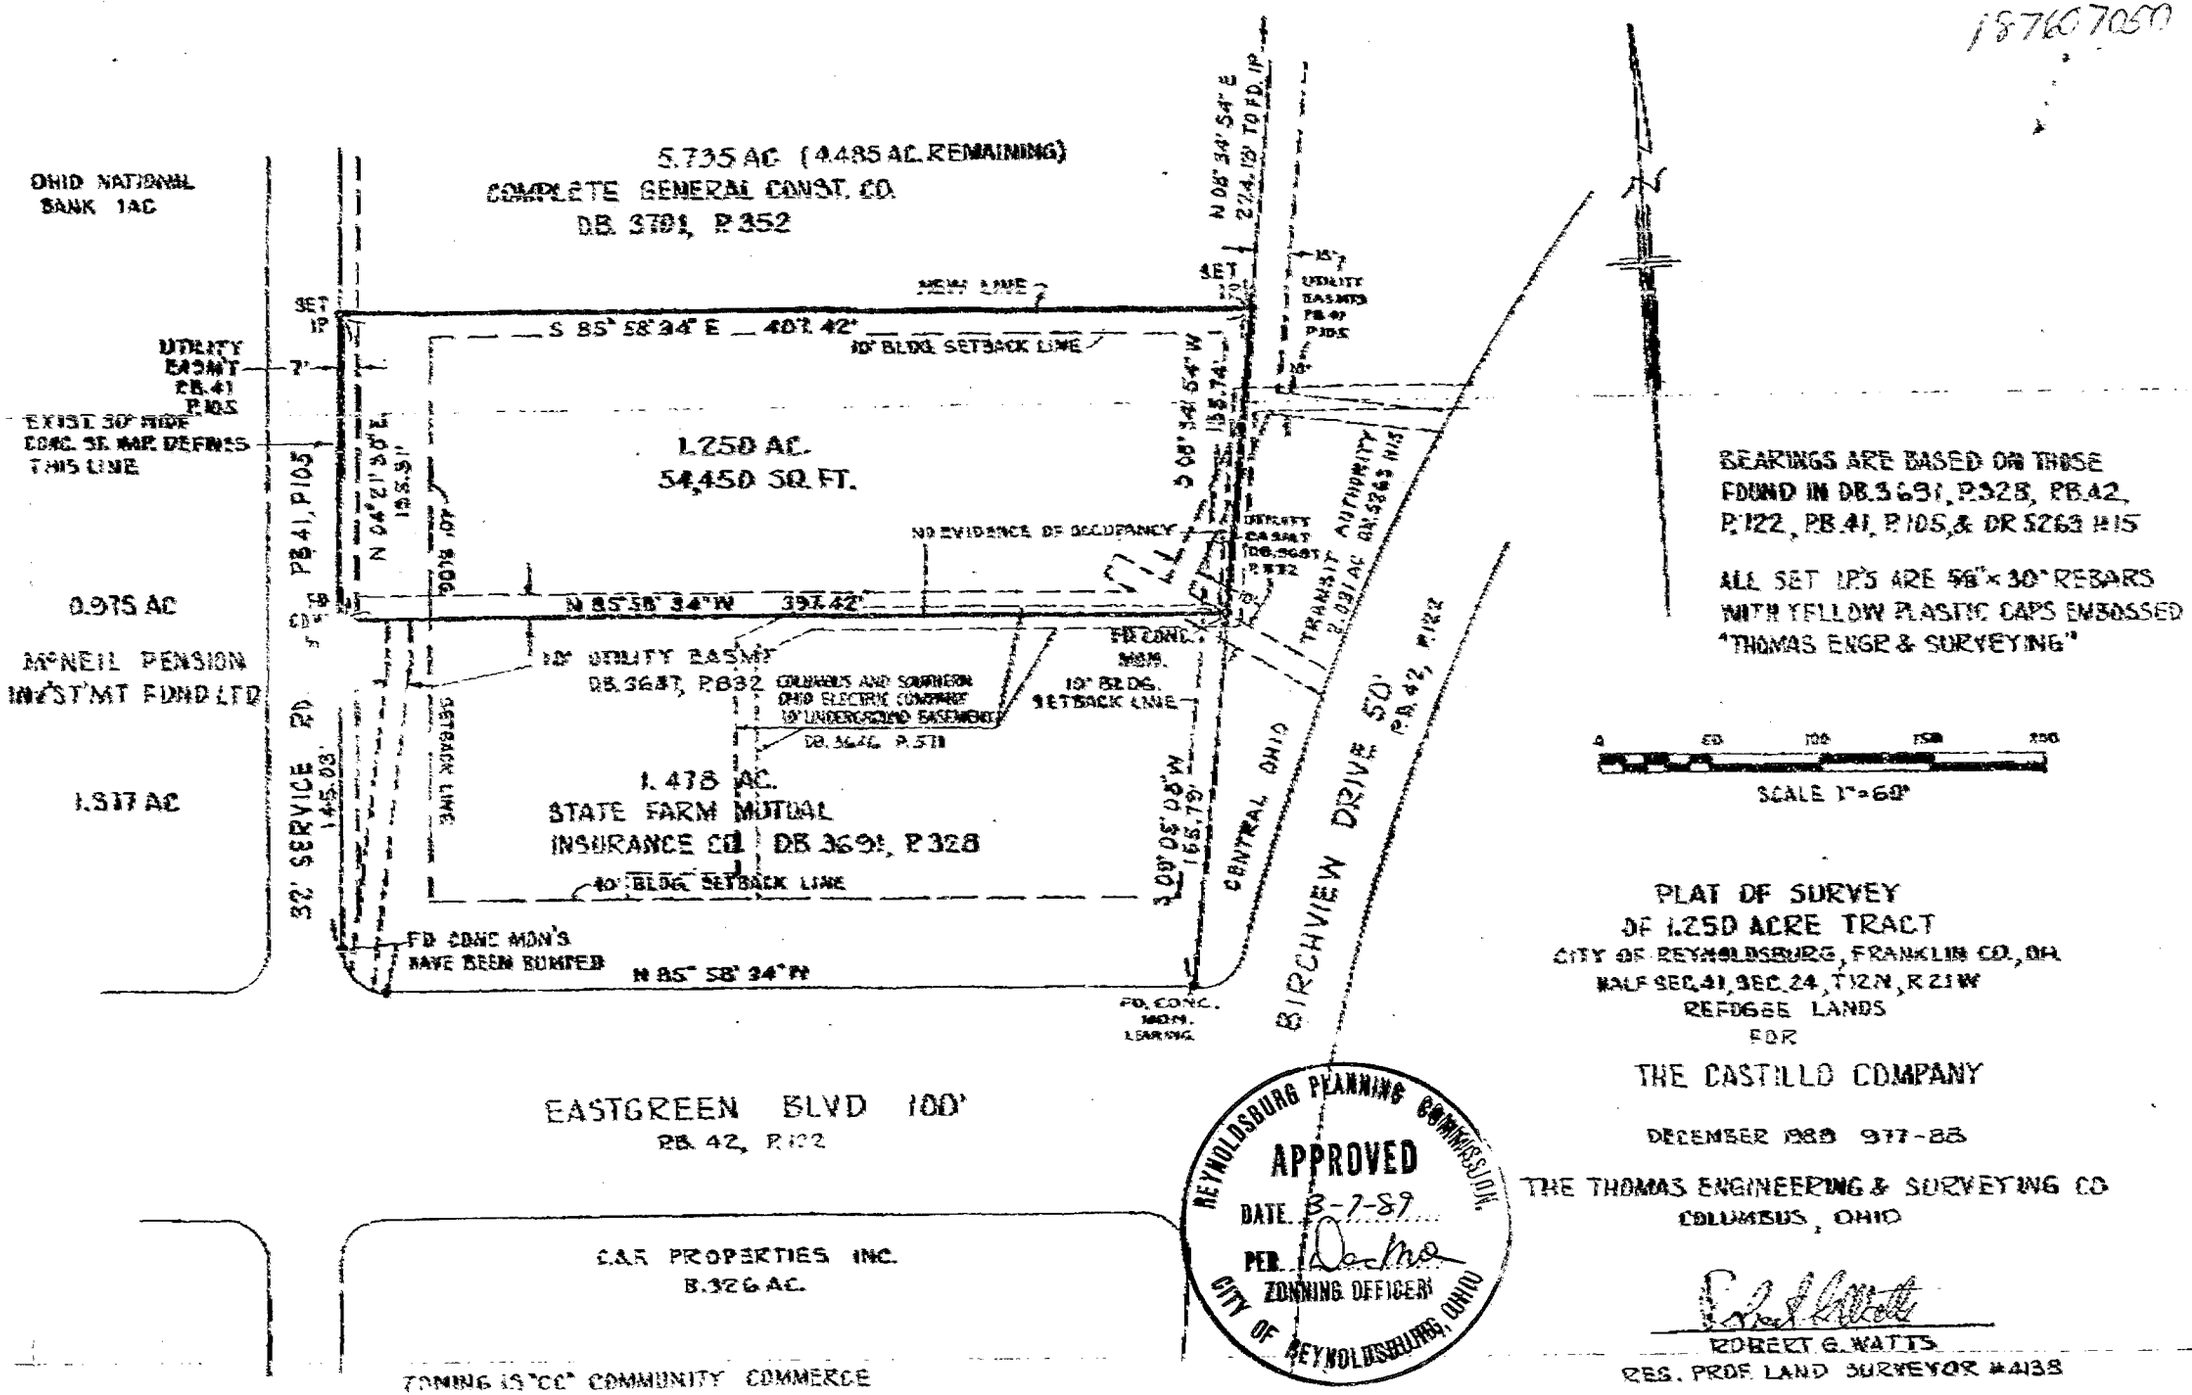

BEARINGS ARE BASED ON THOSE FOUND IN DB.3691, P.328, PB.42, P.122, PB.41, P.105, & DR 5263 H15

ALL SET IP'S ARE 5/8" × 30" REBARS WITH YELLOW PLASTIC CAPS EMBOSSED "THOMAS ENGR & SURVEYING"

SCALE 1" = 60'

PLAT OF SURVEY
OF 1.250 ACRE TRACT
CITY OF REYNOLDSBURG, FRANKLIN CO., OH.
HALF SEC. 41, SEC. 24, T12N, R21W
REFUGEE LANDS
FOR
THE CASTILLO COMPANY

DECEMBER 1988 977-88

THE THOMAS ENGINEERING & SURVEYING CO
COLUMBUS, OHIO

ROBERT G. WATTS
REG. PROF. LAND SURVEYOR #4138

COMPLETE GENERAL