1880 7125
1880 7100

EVANS MECHWART HAMBLETON & TILTON

CONSULTING ENGINEERS - SURVEYORS
GAHANNA, OHIO

Sheldon Pol 3507

0-1061

PLAT OF 4.528 ACRE TRACT

Being a part of ½ Sec. 7, Sec. 7 of Tp. 16, Range 20, Refugee Lands
City of Reynoldsburg, Ohio

SCALE 1" = 80'

o = Iron Pin
March 20, 1965
Revised May, 15, 1965

DEED BOOK _____, PAGE _____
PLAT BOOK _____, PAGE _____

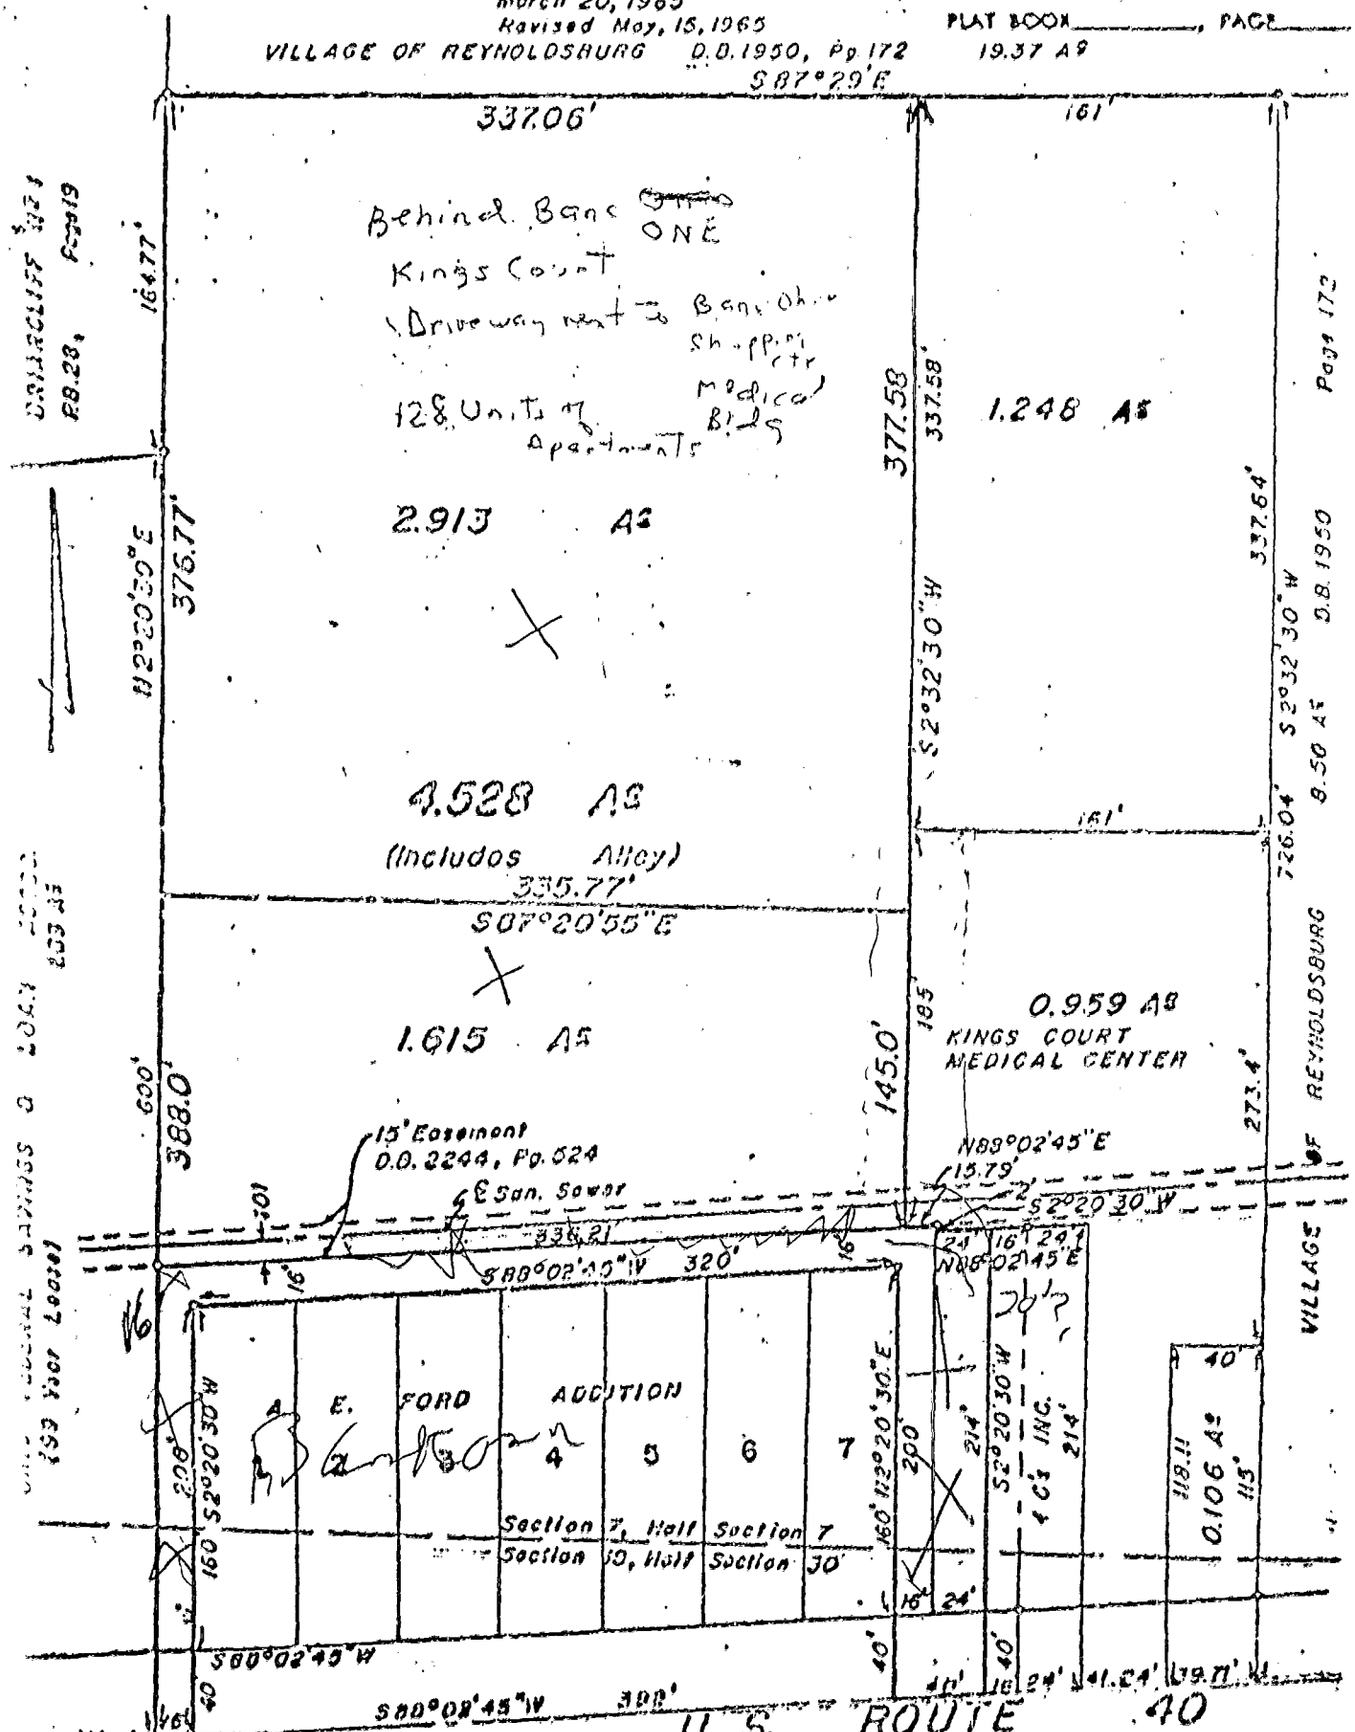

We hereby certify that the foregoing plat was prepared from an actual survey of the premises and shows the location of the boundaries

Revised to include Alley's of "A.E. Ford Addition" at client's request

EVANS MECHWART HAMBLETON & TILTON

BY E. E. Maddy
Registered Surveyor 9966

0-106-D