
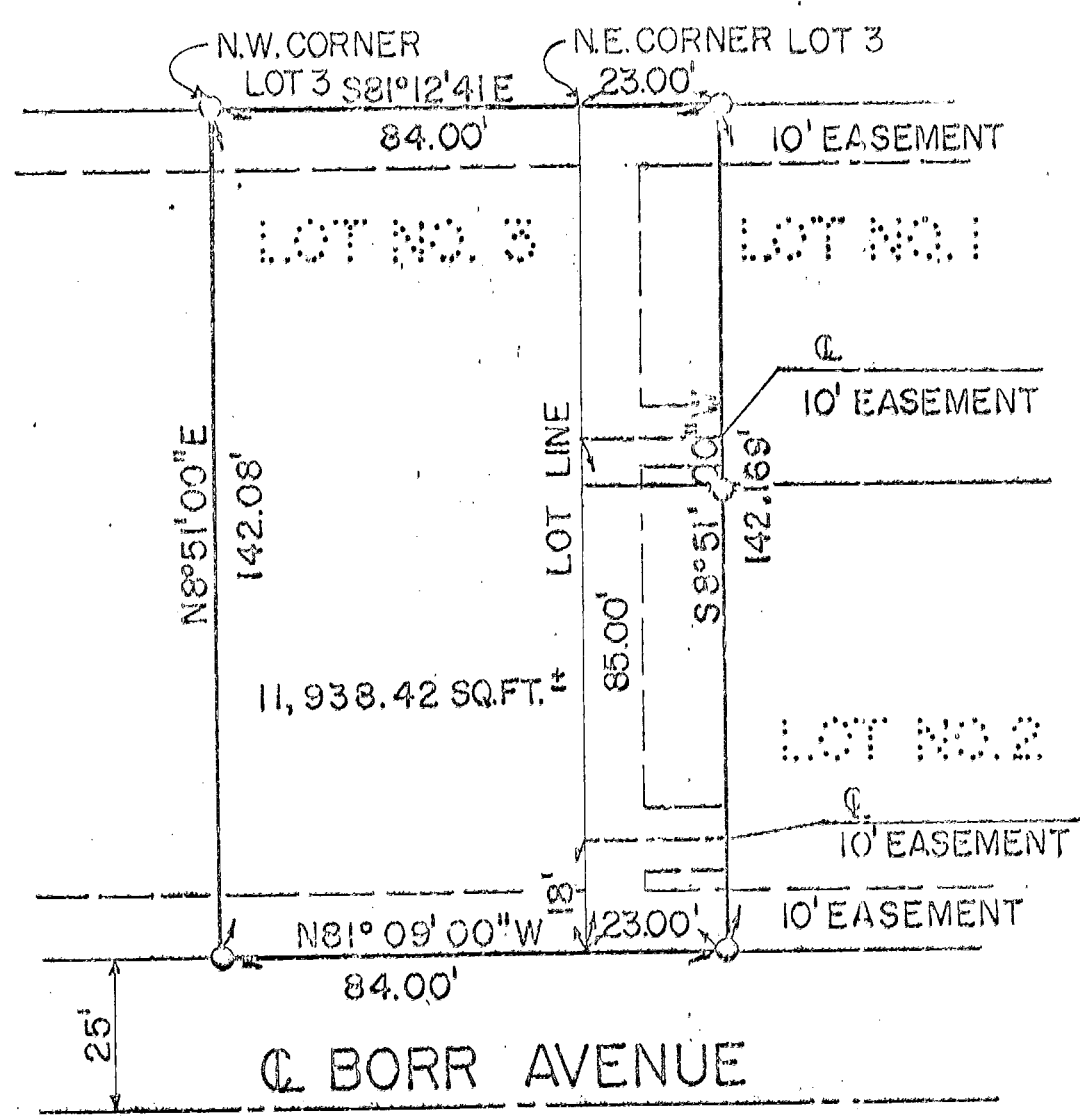


18785 7125

N-107-B

N-107-8

● IRON PIN, SET

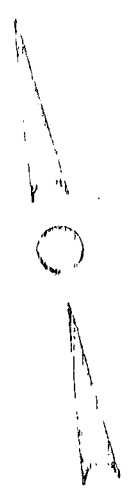

Glenn J. Karr & Linda Karr

I CERTIFY THIS TO BE AN ACCURATE PLAT OF THE

PROPERTY AT Borr Avenue, Columbus, Ohio AS SURVEYED BY ME, BEING Lot No. 3 and part of Lot No. 1 and Part of Lot No. 2 in Kingsridge Subdivision

A PLAT OF WHICH IS OF RECORD IN PLAT BOOK NO. 42 PAGE 50 IN THE OFFICE OF THE COUNTY RECORDER OF Franklin Co., Ohio.

Signed Tracey D. Hess

Surveyor's Seal

SCALE: 1 INCH = 30 FEET

TRACEY D. HESS
REGISTERED SURVEYOR
223 HERMITAGE RD., GAHANNA, OHIO
OHIO REGISTRATION No. 5623

DATE July 27, 1977