

MYERS SURVEYING CO.

2700 East Main Street, Columbus 9 (Bexley), Ohio


BEING PART OF A 3.875 AC. TRACT IN 1/2 SEC. 18, SEC. 12, TWP. 12, RANGE 21, REFUGEE LANDS, TRURO TWP., FRANKLIN CO., OHIO

FOR

GALBREATH MORTGAGE CO. 0-106-D

P.B. 2035 Page 617
Scale 1"=60'

Franklin Co. Rec. Office
6 · 26 · '6

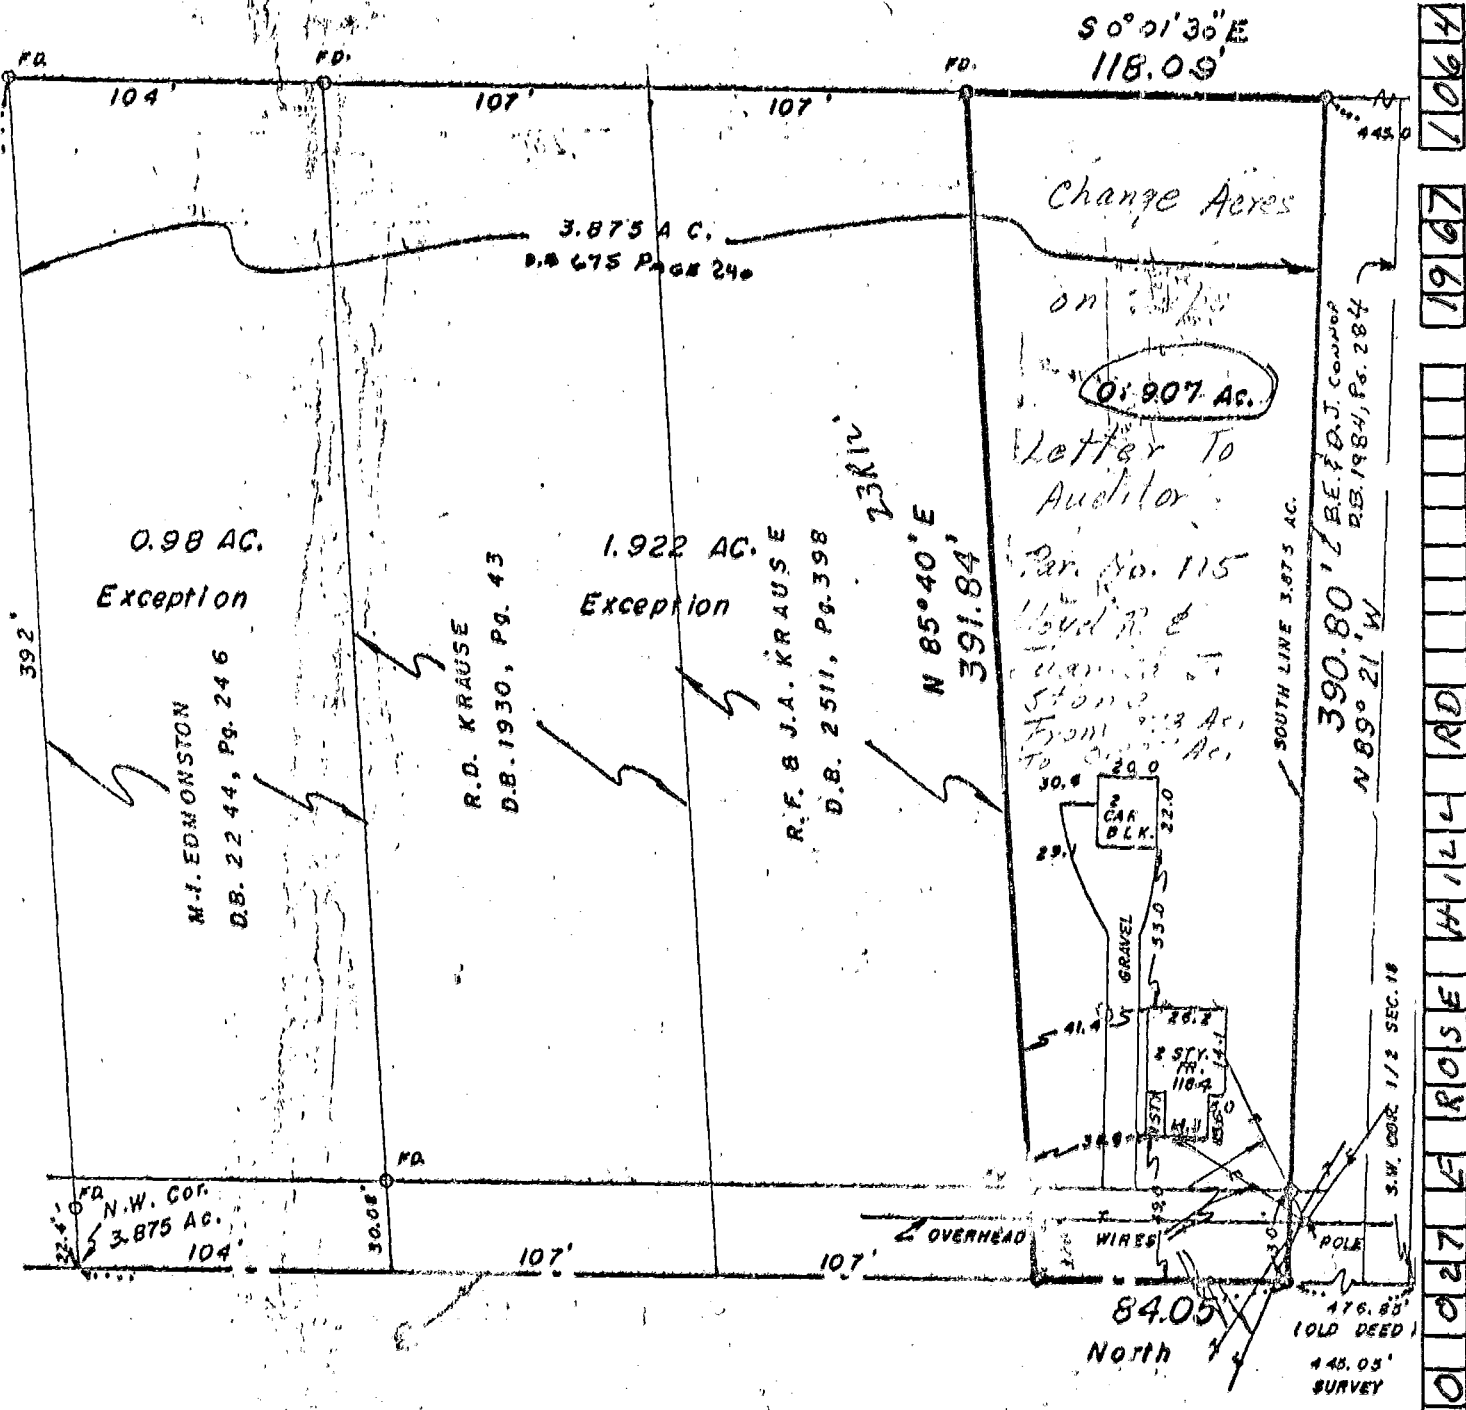

ROSE HILL RD.

T • TELEPHONE
E • ELECTRIC

We hereby certify that the foregoing plat was prepared from an actual survey of the premises. No side line of principal building is less than dimension shown. Iron pins not set unless indicated thus: ()

MYERS SURVEYING CO.
BY: *[Signature]*
Registered Surveyor

ESKEY

1064
1967
RD
ROSE
027
120
080
3880