


88607125

8860-7125 0-106-F



TRURO TWP

**SURVEY OF ACREAGE PARCEL**  
**LOCATED IN SECTION 8, TOWNSHIP 16, RANGE 20,**

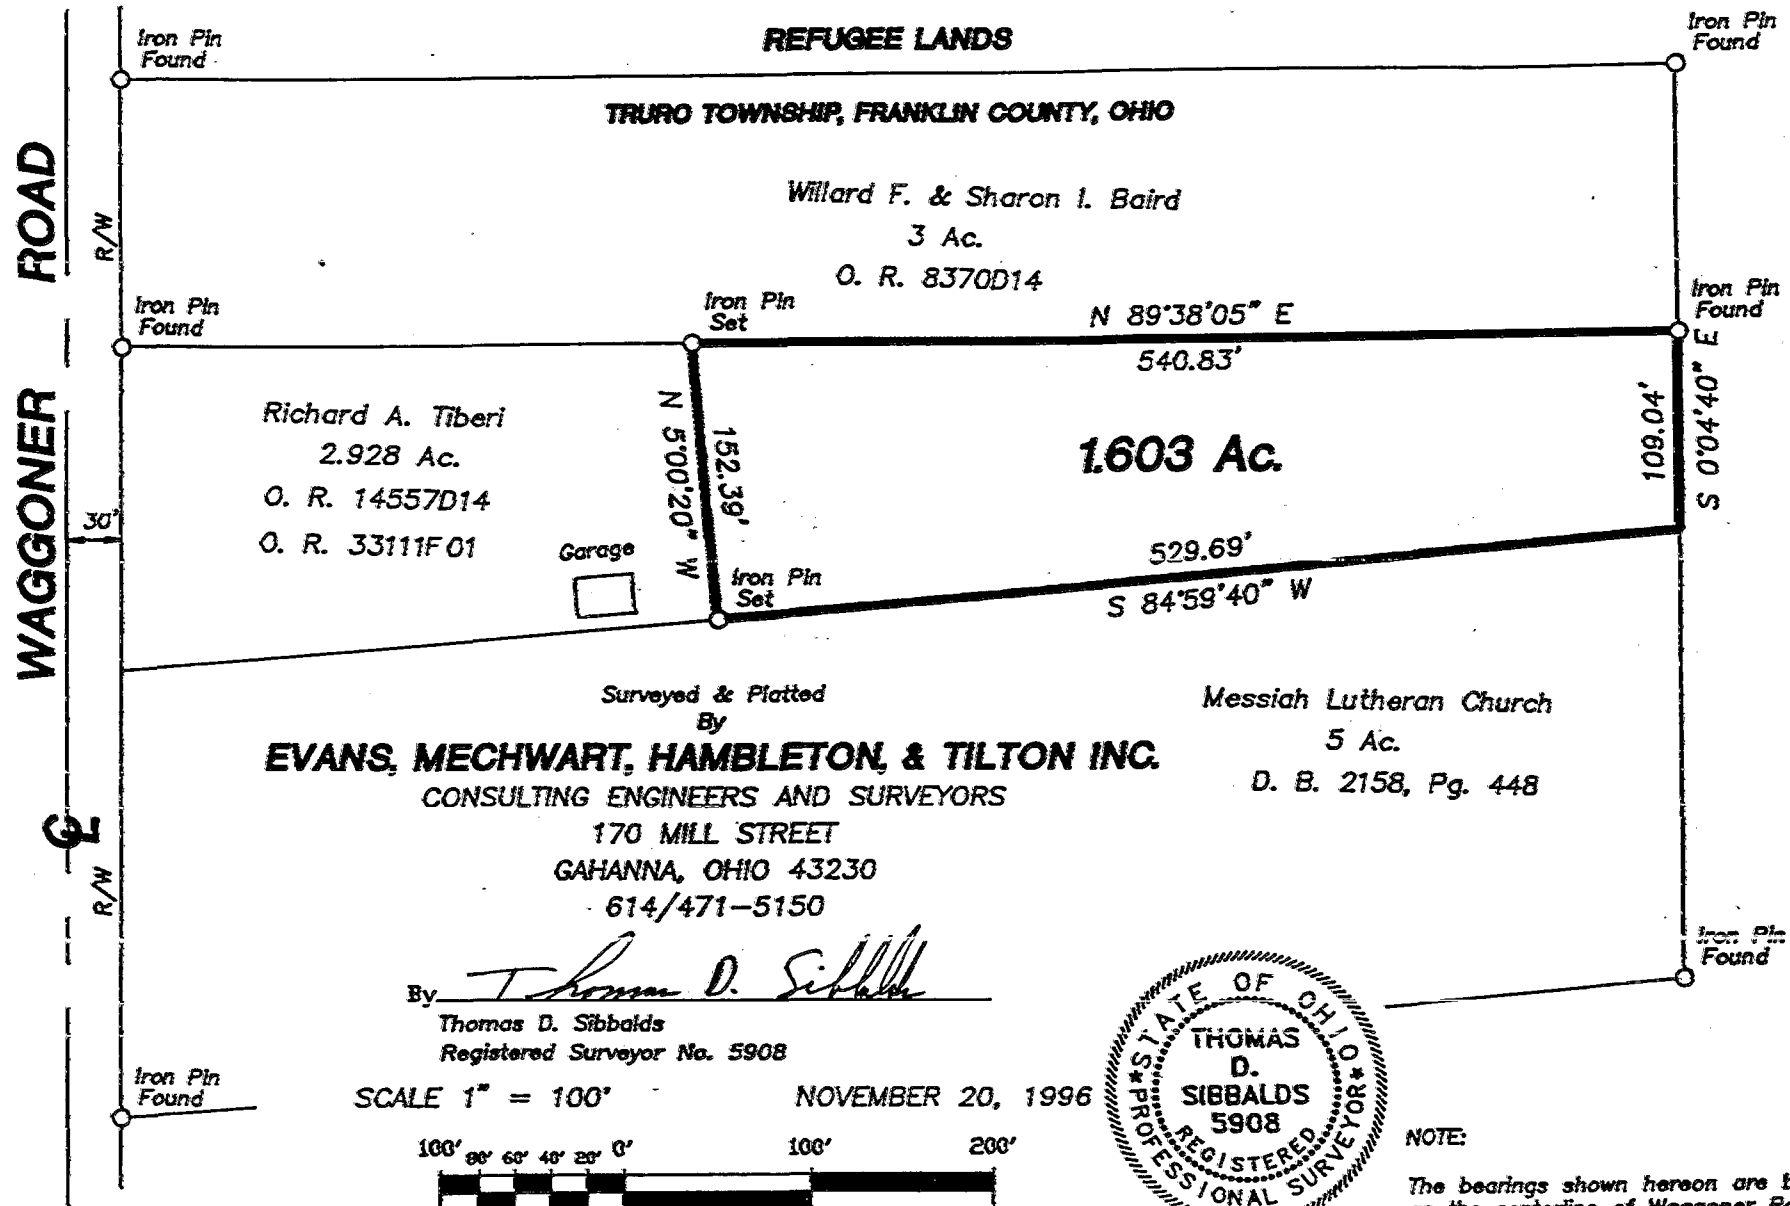

Surveyed & Platted  
By  
**EVANS, MECHWART, HAMBLETON, & TILTON INC.**  
 CONSULTING ENGINEERS AND SURVEYORS  
 170 MILL STREET  
 GAHANNA, OHIO 43230  
 614/471-5150

By Thomas D. Sibbalds  
 Thomas D. Sibbalds  
 Registered Surveyor No. 5908

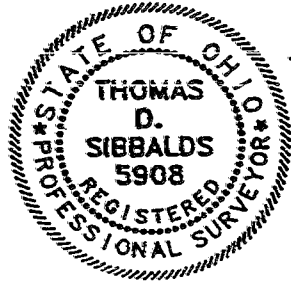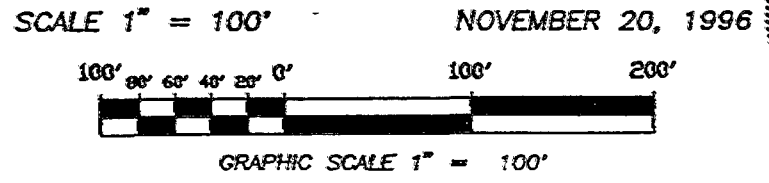

NOTE:

The bearings shown hereon are based on the same meridian as the centerline of Waggoner Road ( N 0° 04' 00" W ) of record in Official Record J3111F01.

8860-7125

0-106-F  
 50114 d  
 263' 6"