

188607150

# Myers Surveying Company, Inc.

2740 East Main Street, Columbus 43209 (Bexley), Ohio  
614-235-8677 FAX: 614-235-4559


A Boundary Survey prepared for and certified to:  
**Perfection Construction**

**Legal Description:** Situated in Ohio, County of Franklin, City of Reynoldsburg, Being Two 0.147 Acres tracts and a 14 foot ingress-egress easement in Half Section 8, Township 16, Range 20, Refugee Lands.

**Applicant:**



**Posted Address:** 7732 Quarry Cliff, Reynoldsburg, Ohio

**Apparent Encroachments:** 1) None

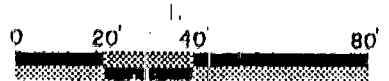

Scale: 1" = 40'

Date: 8-5-'92

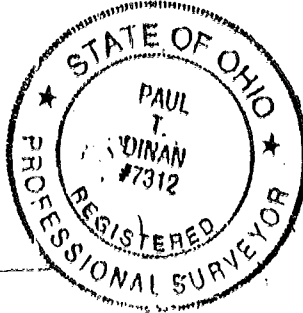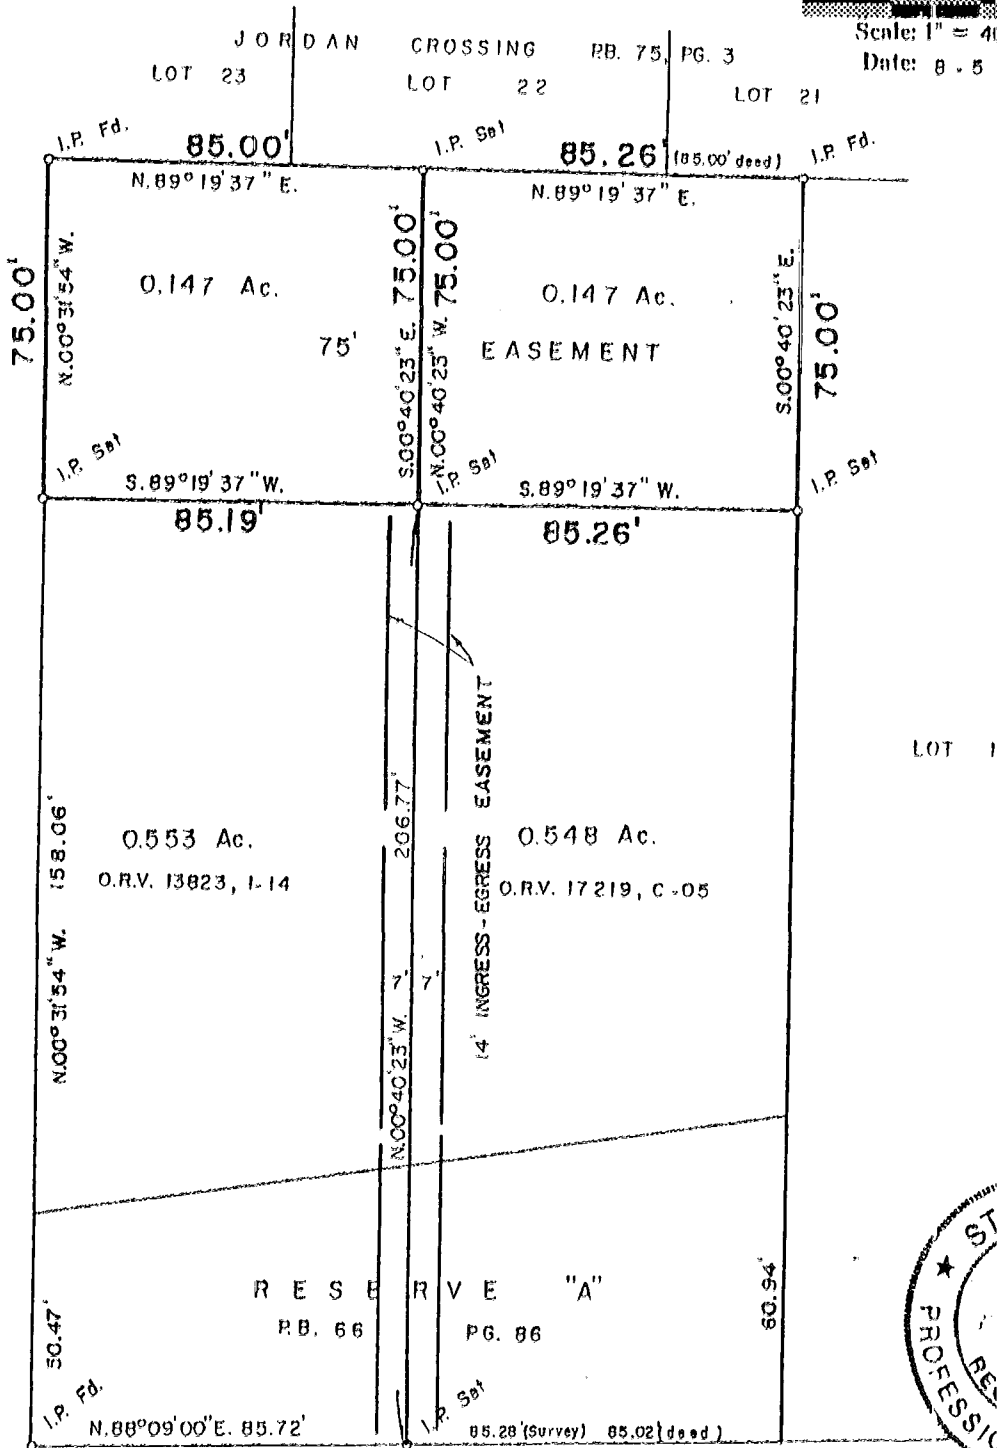

## QUARRY CLIFF CT. 50'

We hereby certify that the foregoing Boundary Survey was prepared from actual field measurements in accordance with Chapter 4733-37 Ohio Administrative Code. Iron pins set are 30"x1" O.D. with an orange plastic plug inscribed "P.S. 6579", unless otherwise noted. Basis of bearing is plat of Quarry Cliff in Plat Book 66, Page 86.

Myers Surveying Co., Inc.  
By *Paul T. Dinan*  
Professional Surveyor

Myers Order No. - 13-08/04/92    Rec.    Field *JD*    DWG *JD*    Ltr. *JD*    ck.

0-106-C