

Job 69-907

N-156-F

R.D. WILLIS & ASSOCIATES

ENGINEERING AND SURVEYING

187857100  
188107100


6784 LAIRD AVENUE

REYNOLDSBURG, OHIO

TELEPHONE 866-0000

A SURVEY OF A PART OF AN 8,221 ACRE TRACT OF LAND SITUATED IN THE CITY OF REYNOLDSBURG, COUNTY OF FRANKLIN, STATE OF OHIO, Deed Book 2456, Page 84.

BRIARCLIFF DRIVE 50'

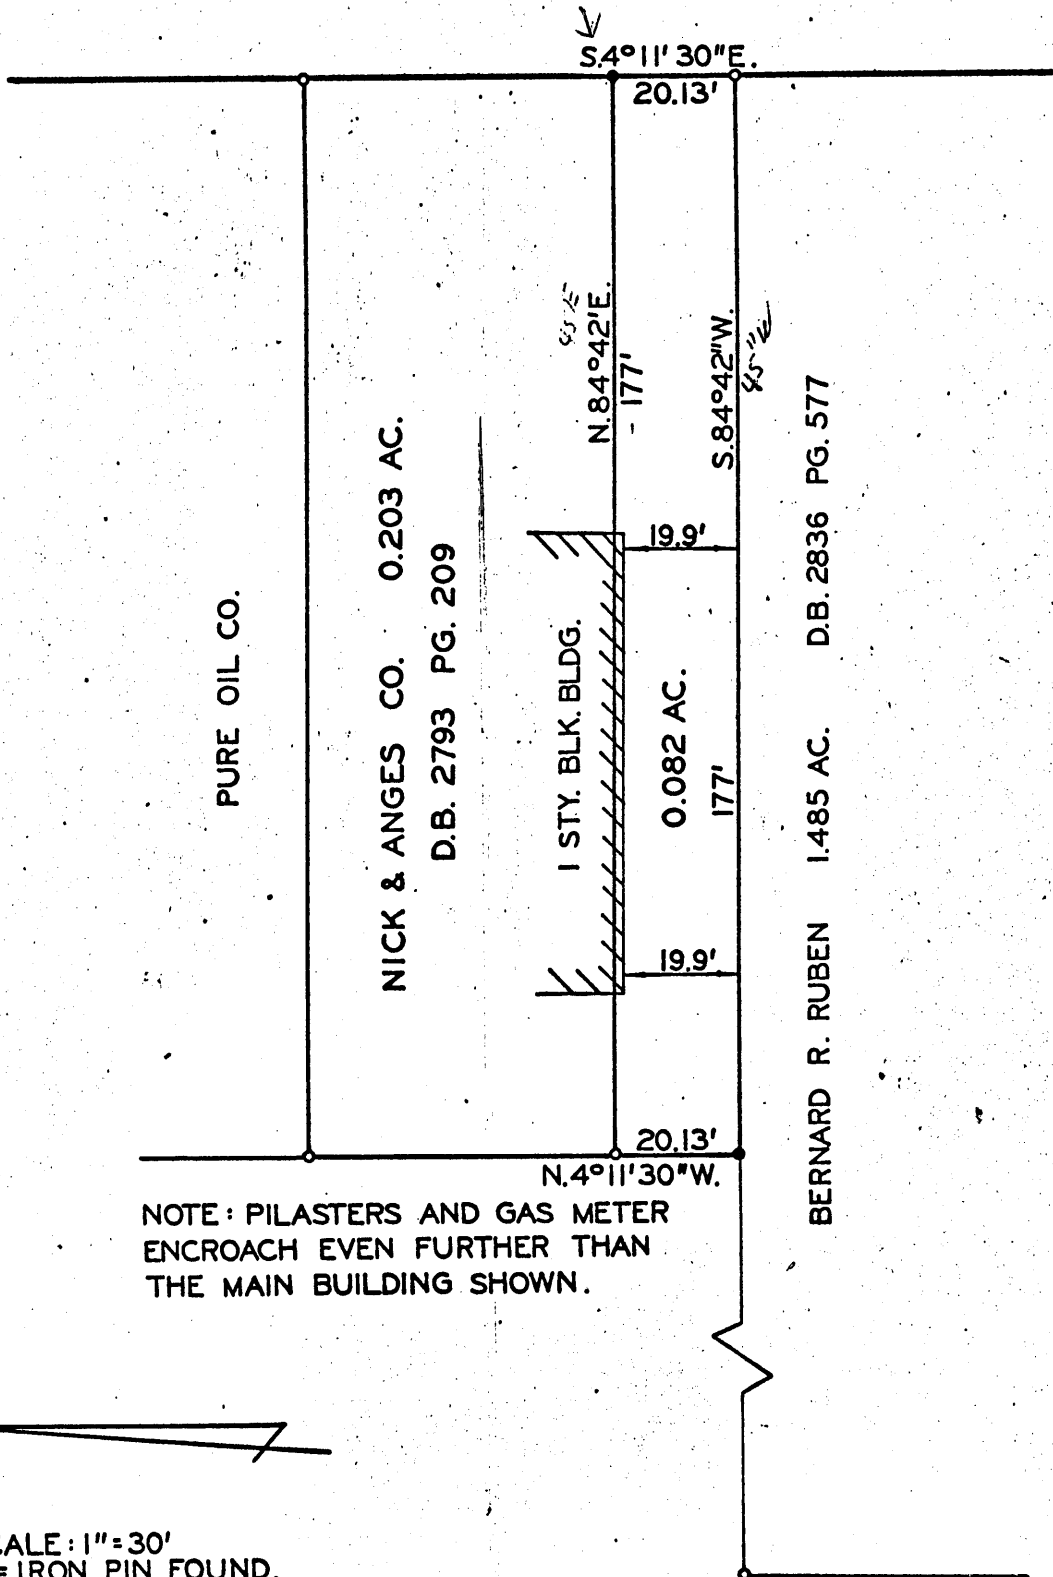

NOTE: PILASTERS AND GAS METER ENCROACH EVEN FURTHER THAN THE MAIN BUILDING SHOWN.

SCALE: 1"=30'  
○ = IRON PIN FOUND.  
● = PUNCH HOLE SET IN CONCRETE.

We hereby certify that the foregoing plat was prepared from an actual survey of the premises and shows the location of the boundaries.

Issued: 9-2-19

By: *Roy D. Willis*  
Dist. Surveyor No. 5365