18785 7100

O-106-D
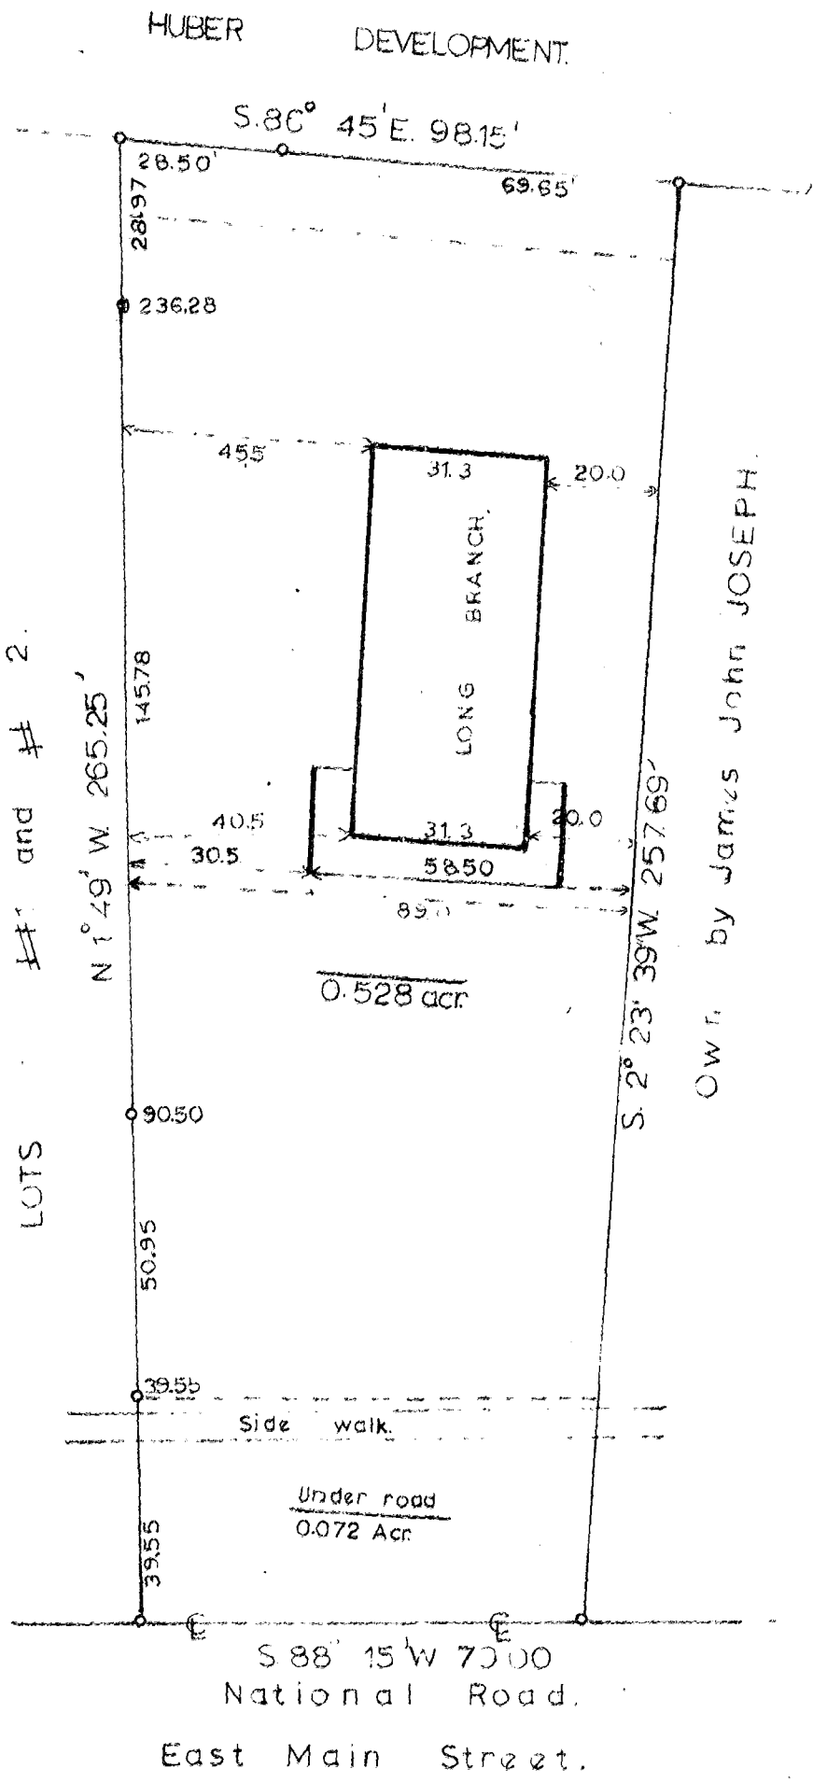
Scale 1" = 30 Ft.