0-106-E

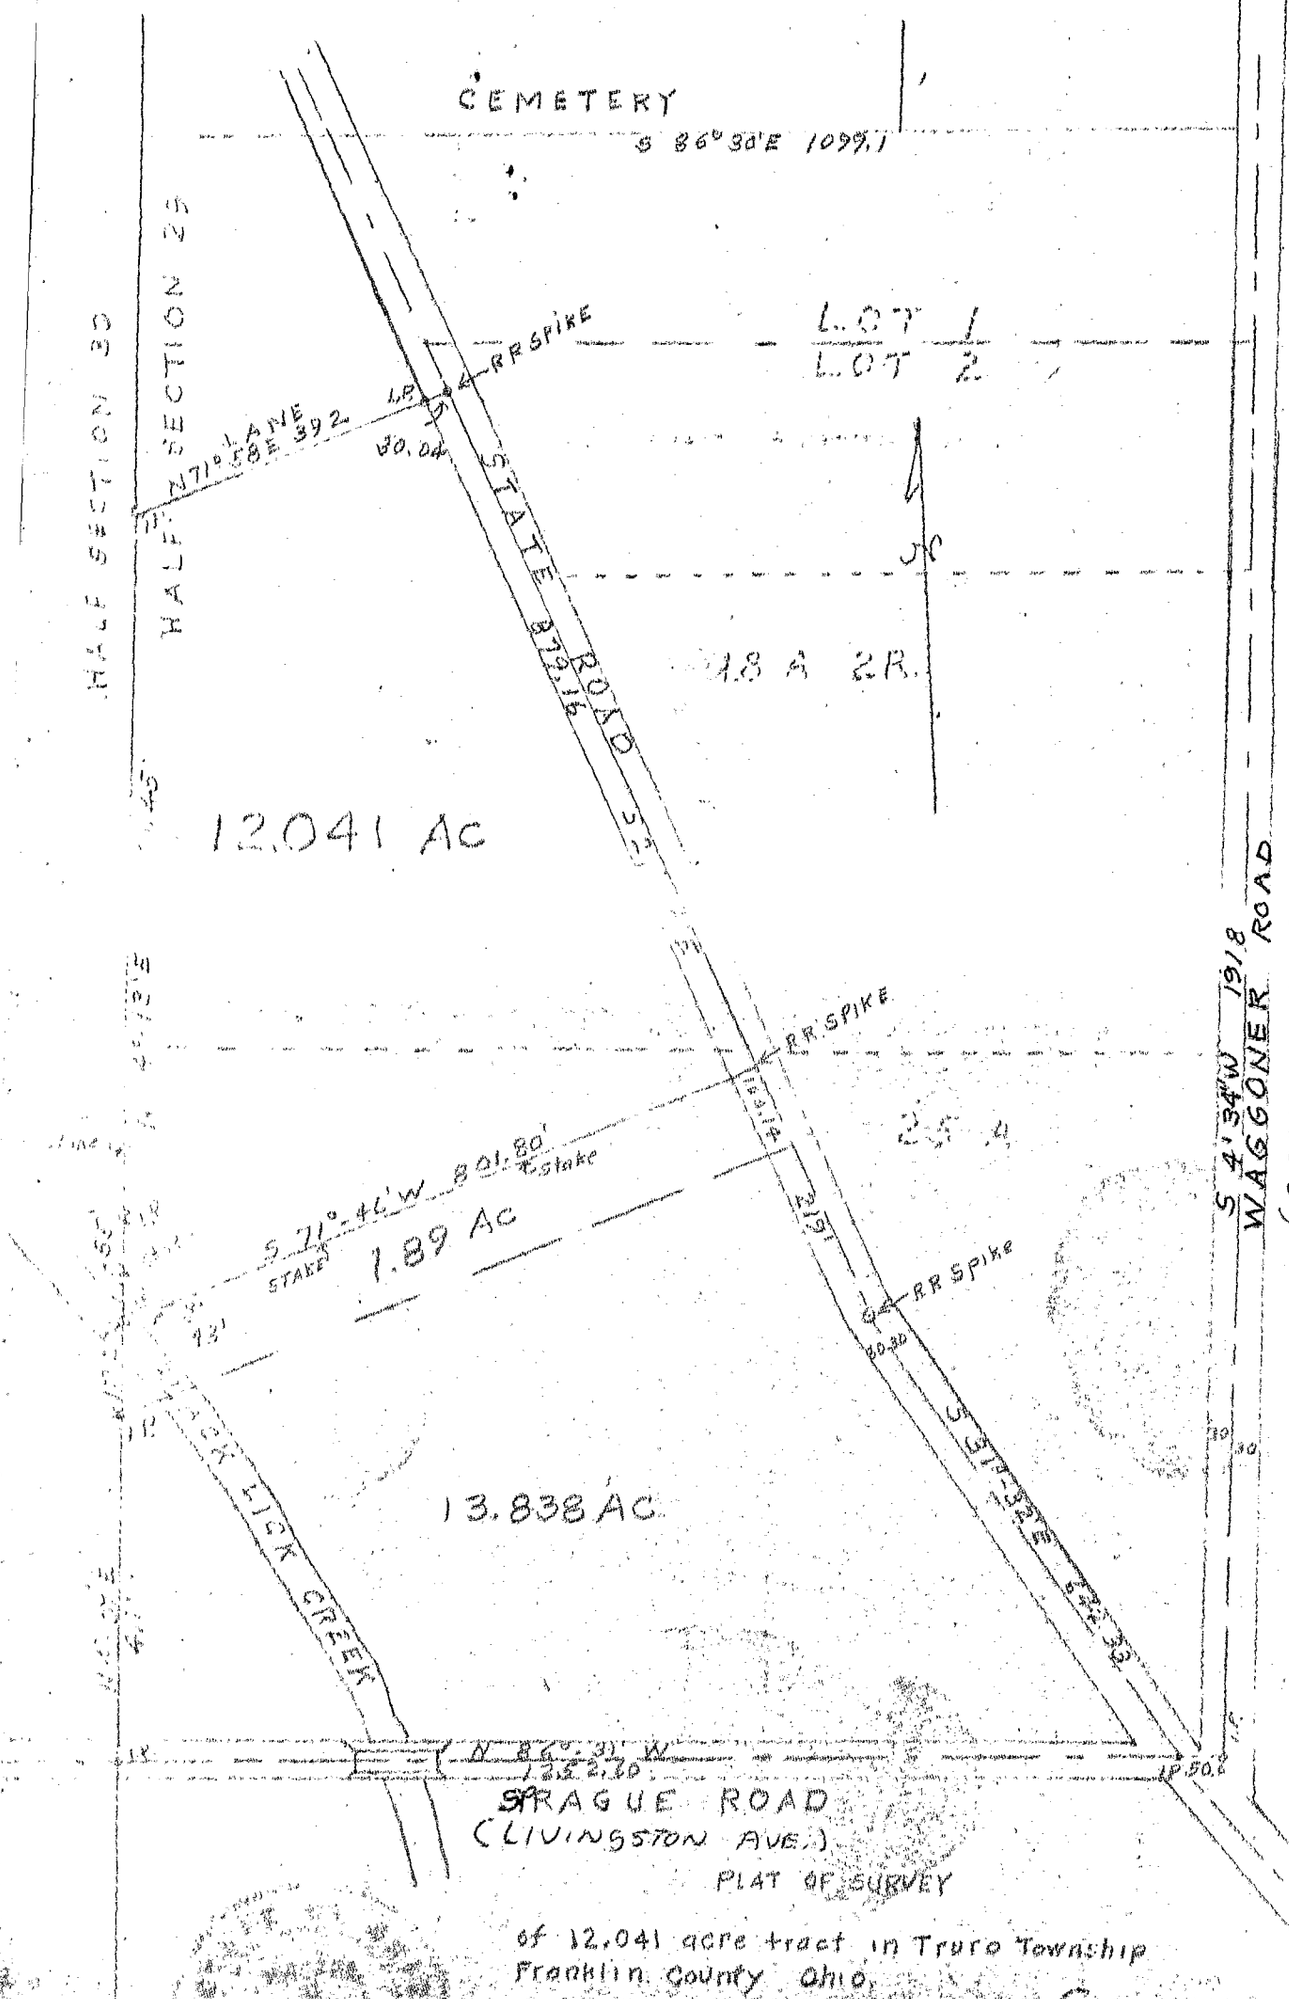

PLAT OF SURVEY

of 12.041 acre tract in Truro Township
Franklin County Ohio.

Made for Mr. Loren G. Windom
By Jas. O. Thomas, Surveyor

October 8, 1934 Scale 1" = 200'

18835 7100
18835 7125

93 1066 1934 WINGSTON 1001 0471 1128 4650