


18667795

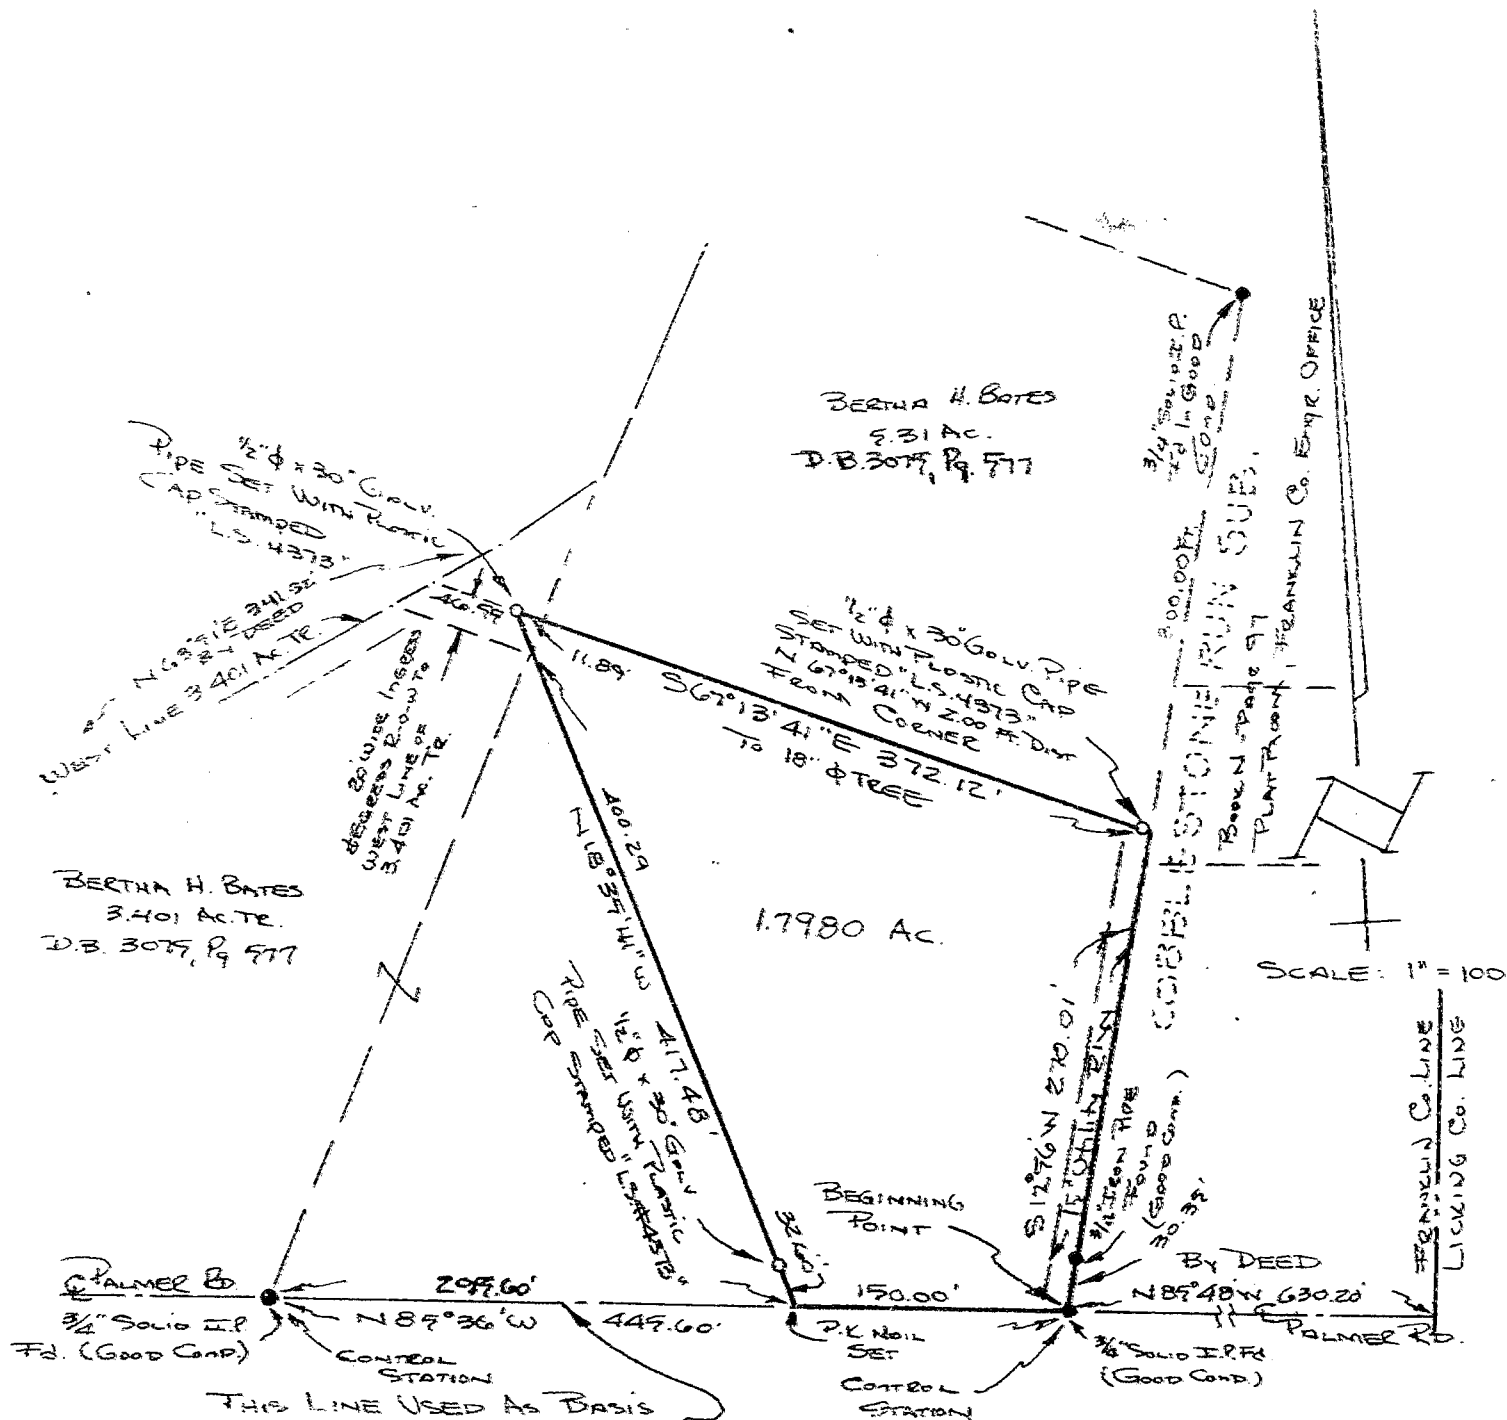

LEGEND

- INDICATES IRON PIN FOUND
- INDICATES IRON PIN SET
- 1/2" x 30" GALV IRON PIPE
- P.K. NAIL SET - 1 1/2" LONG

H-901-0