



85356950

0-41B
MADISON TWP

BASIS OF BEARINGS:

Q WINCHESTER PIKE AS SHOWN ON
RIGHT-OF-WAY PLAN S.H. 49, SEC. F., E-1
FRANKLIN CO. ENGINEER'S OFFICE

SURVEY PLAT OF
0.939 ACRES
BEING PART OF A 1.178 ACRE TRACT
SITUATED IN
SECTION 5, TOWNSHIP 11, RANGE 21
MATHews SURVEY
CITY OF COLUMBUS, FRANKLIN CO., STATE OF OHIO

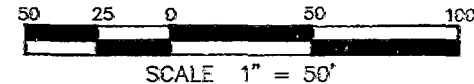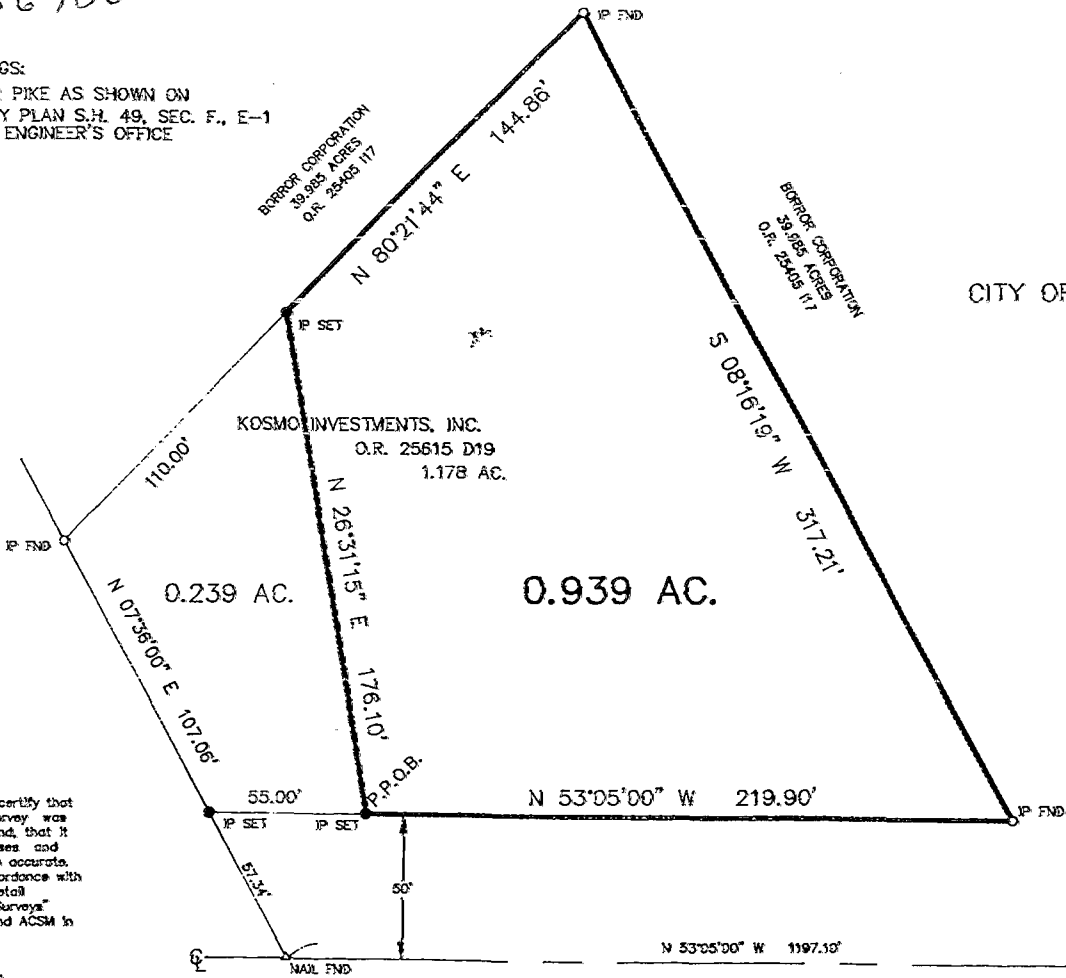

WATKINS ROAD
P.O.B.
RRS FND

Steven A. Solomon
STEVEN A. SOLOMON, P.S. No. 7243

FEBRUARY 23, 1994
CERTIFICATION: We hereby certify that the foregoing boundary survey was actually made upon the ground, that it and the information, courses and distances shown thereon are accurate. This survey was made in accordance with the "Minimum Standard Detail Requirements for Land Title Surveys" promulgated and presently established by ALTA and ACSM in 1985.

SAS Surveying
30 Ridgecliff Rd.
Columbus, Ohio 43221
614-538-8600
Professional Land Surveying

0-41-B