


SCALE 1" = 200'

May 28, 1997
o = Iron Pin

RECORD REFERENCES _____

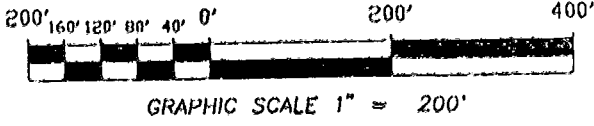

RB-3 Associates & Stephen B. Goodman
38.727 Ac.
O.R. 18567 C13

11.148 Ac.


Kobacker Co.
11.998 Ac.
O.R. 14686 F04
O.R. 14686 F06

BRICE RD.

TUSSING

RD.

Bearings shown hereon are based on the same meridian as the bearing of the centerline of Tussing Rd. (S85°43'00"E) of record in O.R. 18567C13

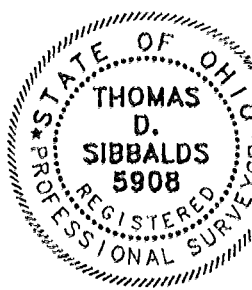

7/12/20
87607000
607025

E.M.H.&T. INC.

We hereby declare that the foregoing plat was prepared from an actual survey of the premises and shows the location of the boundary and improvements, and that there are no encroachments either way across the andary of this lot except as shown hereon.

By Thomas D. Sibbalds
Professional Surveyor No. 5908