N – 156 – G

MYERS SURVEYING CO.

2740 East Main Street, Columbus 43209 (Bexley), Ohio

PART OF LOT 194 EASTSHIRE, SEC. 3 REYNOLDSBURG, OHIO

FOR

METRO TITLE AGENCY, INC.

AND/OR

BANCOHIO MORTGAGE CO.

P.B. 56 *Page* 29
Scale 1"= 20

Franklin Co. Rec. Office
11·21·85

William B. Kuhn

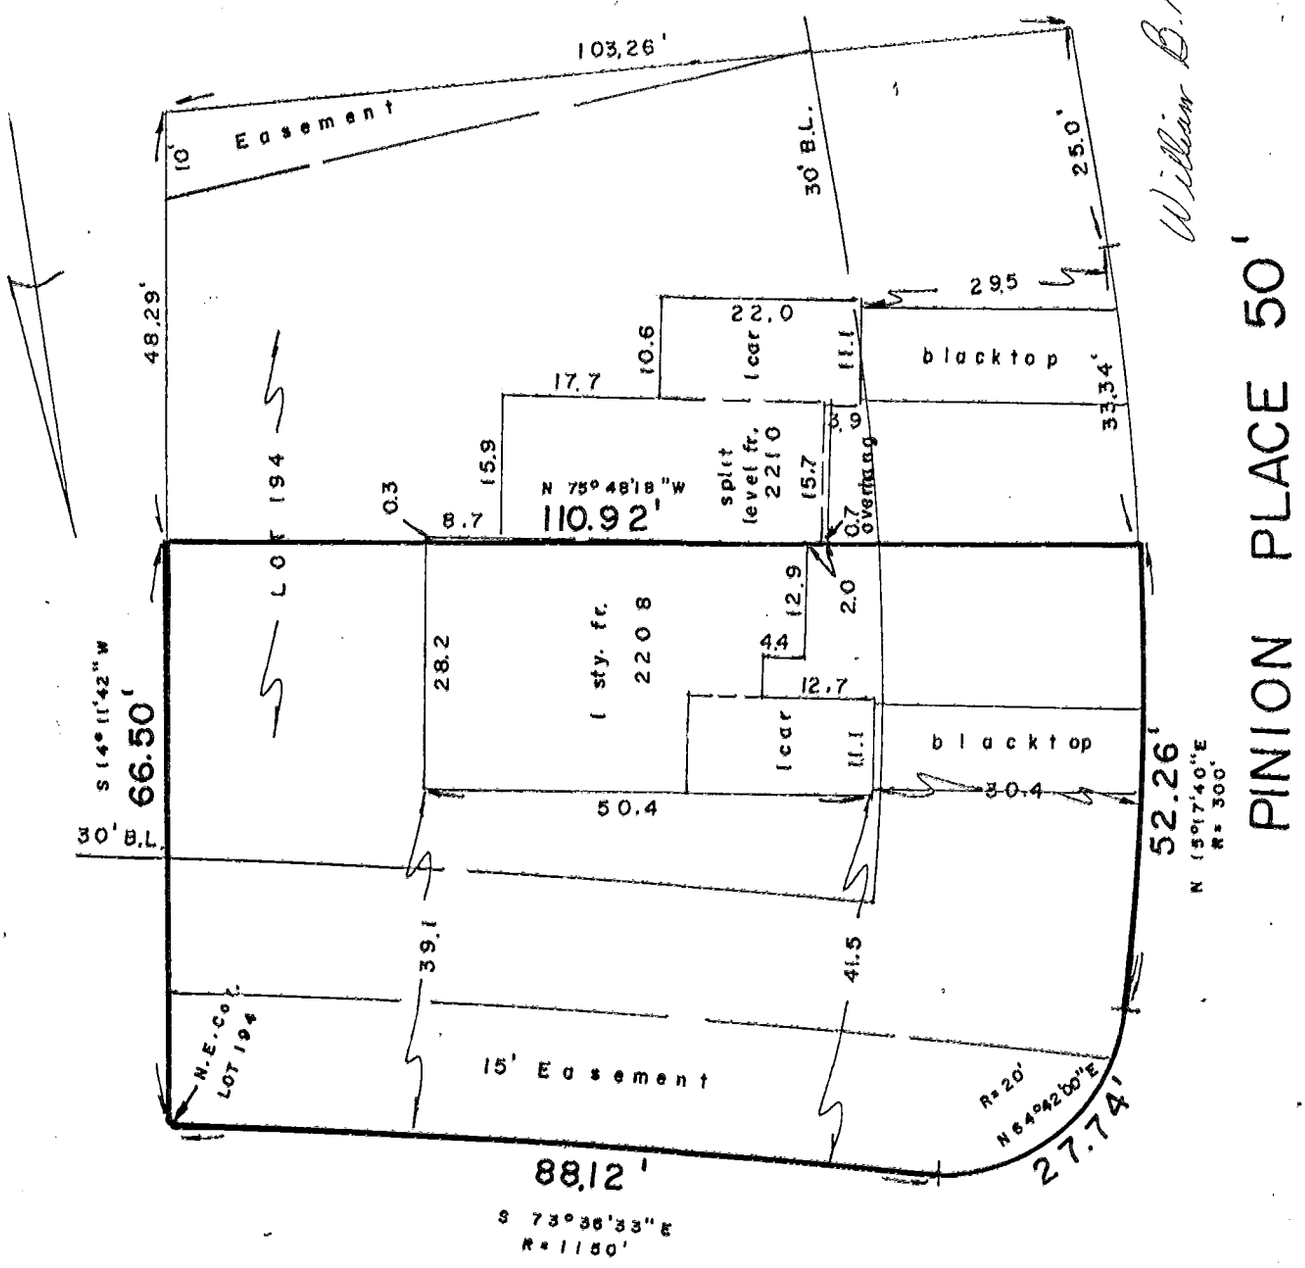

BIRCHVIEW DR. SOUTH 50'

NOT TO BE USED TO ERECT FENCES

STATE OF OHIO
ALBERT J. MYERS
6579
REGISTERED SURVEYOR

We hereby certify that the foregoing plat was prepared from an actual survey of the premises. No side line of principal building is less than dimension shown. Iron pins not set unless indicated thus –0–. For Mortgage Loan & Title Insurance purposes only.

KUHN

MYERS SURVEYING CO.

BY Albert J. Myers
Registered Surveyor

HILLS CO. #1000H