

**SURVEY OF ACREAGE PARCEL**  
 HALF SEC 44, SEC 25, TWP 12 NORTH,  
 RANGE 21 WEST, REFUGEE LANDS  
 CITY OF COLUMBUS, FRANKLIN COUNTY, OHIO


0735-6957

SCALE 1" = 100'

(1.321 Acres)

NOVEMBER 17, 1999

M/I Schottenstien  
 Homes Inc.  
 I.N.

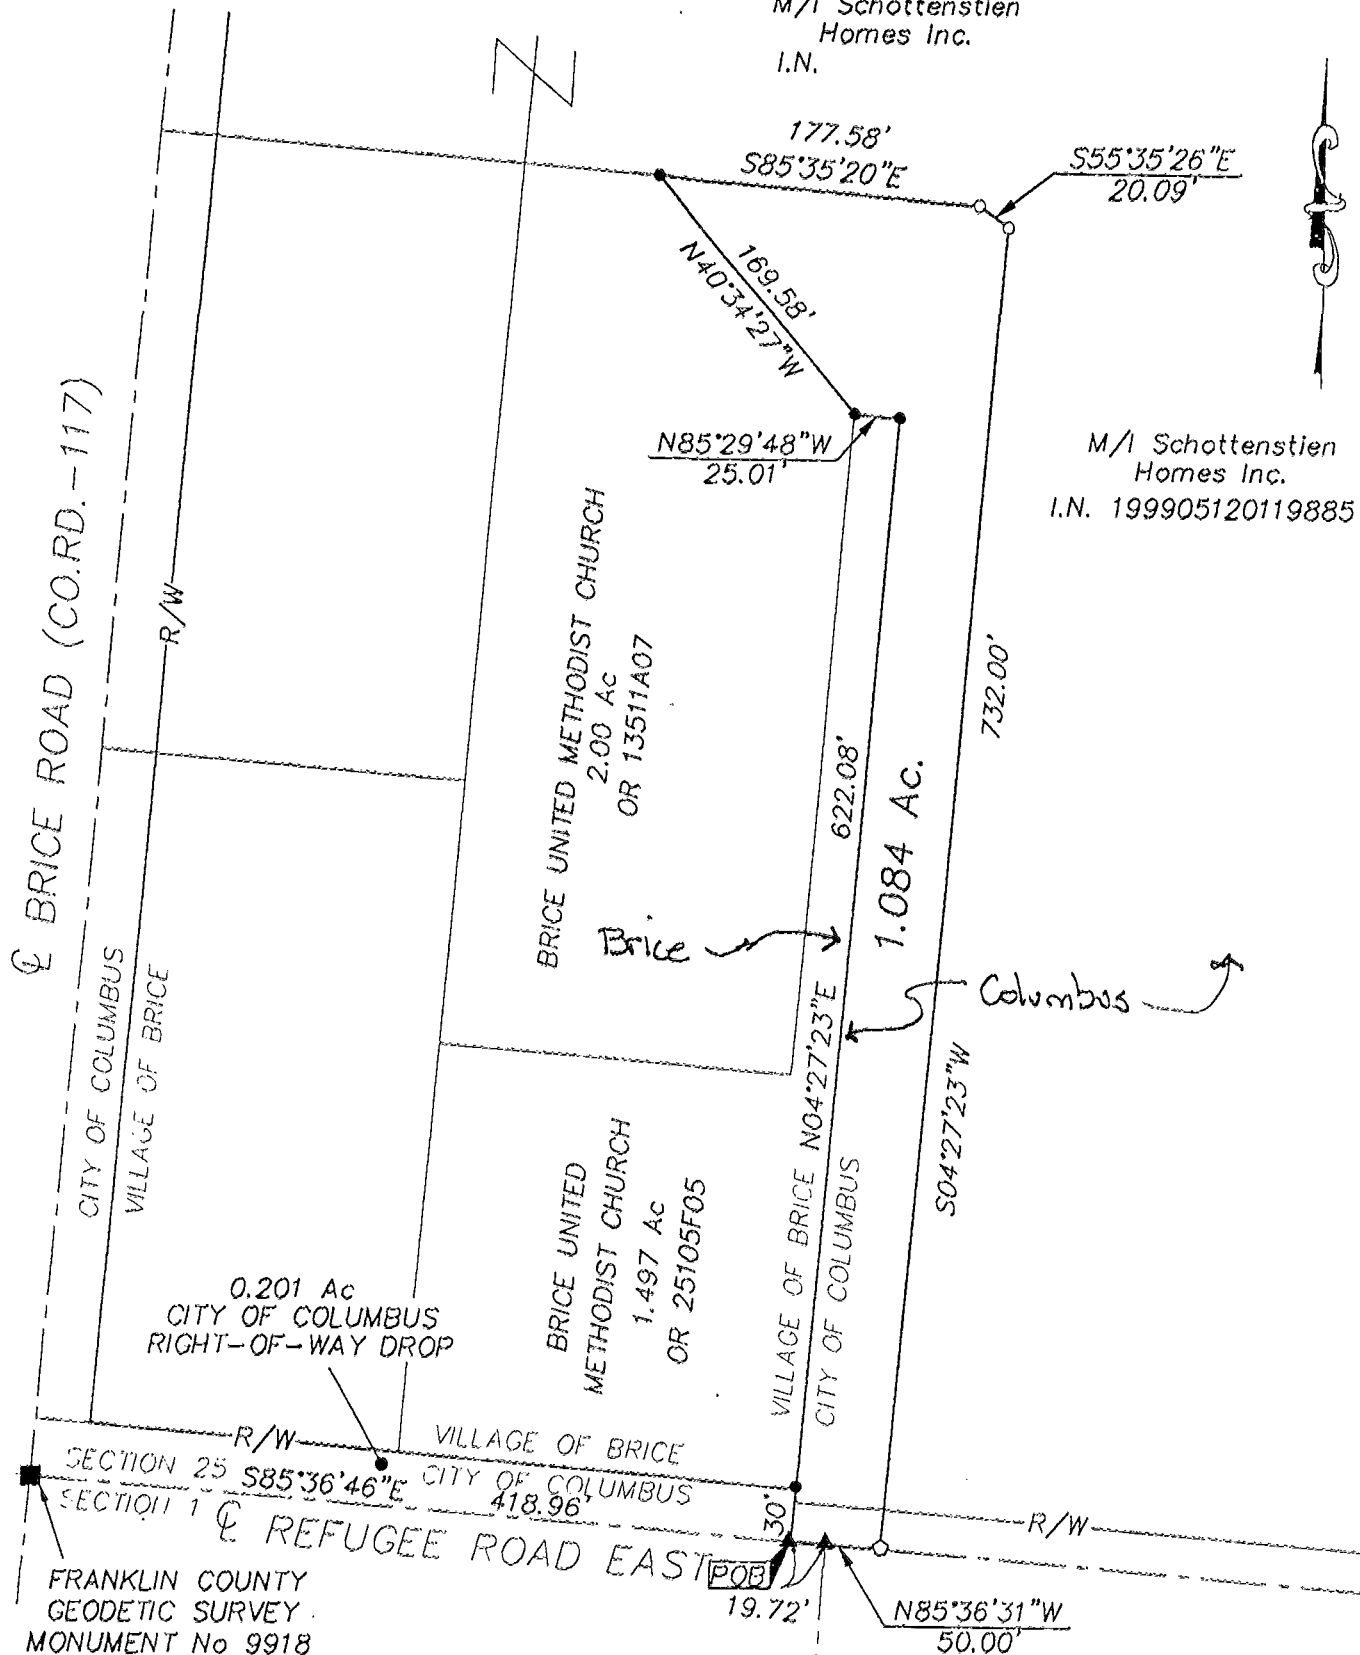

M/I Schottenstien  
 Homes Inc.  
 I.N. 199905120119885

0.201 Ac  
 CITY OF COLUMBUS  
 RIGHT-OF-WAY DROP


FRANKLIN COUNTY  
 GEODETIC SURVEY  
 MONUMENT No 9918

- P.K. Nail Set
- ▲ R.R. Spk. Fnd.
- △ R.R. Spk. Set
- I.P. Fnd.
- I.P. Set

I.P.S Set are 13/16" I.D. Iron  
 30" long w/cap inscribed EMH&T.



GRAPHIC SCALE  
 (IN FEET)

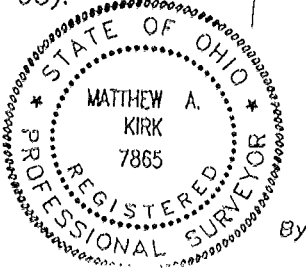

**EMH&T. INC.**

By *Matthew A. Kirk*  
 Professional Surveyor No. 7865

Tracks Twp  
 C-105-B