

EVANS MECHWART HAMBLETON & TILTON, INC.

CONSULTING ENGINEERS — SURVEYORS
GAHANNA, OHIO


SURVEY OF 0.941 ACRE TRACT

Located in S. E. Quarter Section 26, Township 12, Range 21
Refugee Lands
Truro Township, Franklin County, Ohio

SCALE 1" = 60'

April 18, 1968
o = Iron Pin

DEED BOOK 918, PAGE 581
PLAT BOOK _____, PAGE _____

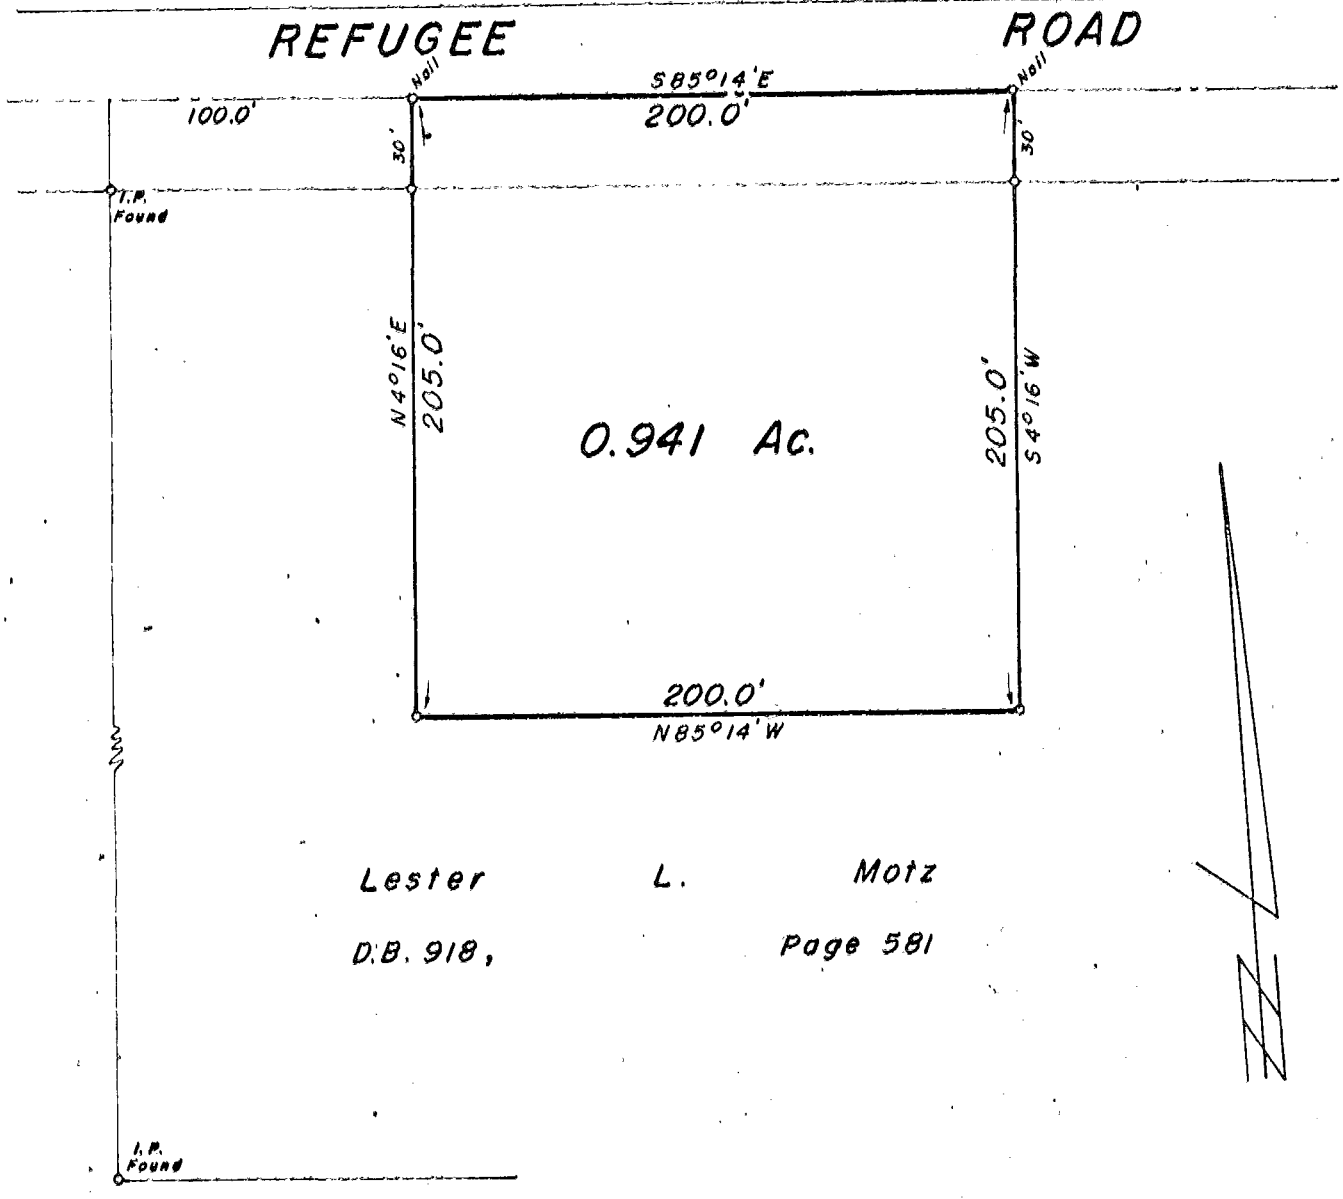

Lester L. Motz
D.B. 918, Page 581

We hereby certify that the foregoing plat was prepared from an actual survey of the premises and shows the location of the boundaries.

EVANS MECHWART HAMBLETON & TILTON, INC.

BY *[Signature]*
Registered Surveyor No. 485

003

046

1968

REFUGEE

BRICE

W

041

120

3700