PREPARED FOR:
MARQUIS HOMES

13453I10

PROPERTY LOCATION

SITUATED IN HALF SECTION 28, SECTION 17
TWP. 1GN, RANGE 20W, REFUGEE LANDS,
CITY OF REYNOLDSBURG, FRANKLIN CO., O.

PLAT PREPARED BY:
D.P.H. SURVEYING, INC.
P.O. Box 429
Thornville, Ohio 43076
Phone: 864-9925

BEING PARTS OF LOT 39 OF FARMINGTON
SECTION 2, AS RECORDED IN PLAT BOOK 65,
PAGE 93.

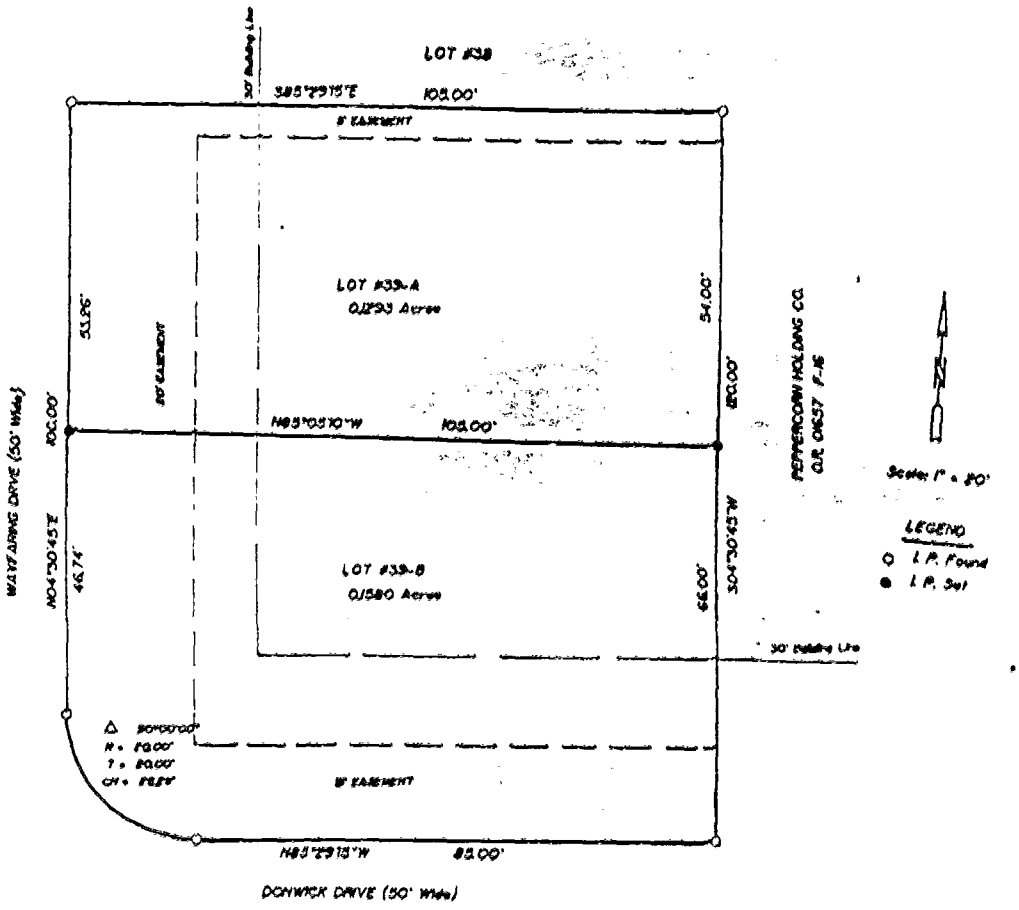

THE BEARINGS OF THIS PLAT ARE BASED ON THE EAST RIGHT-OF-WAY LINE OF WAYFARING DRIVE, THE SAME BEING THE WEST LINE OF LOT 39 AS N04°30'45"E.

ALL IRON PINS SET ARE 5/8" REINFORCING BARS WITH YELLOW CAPS LABELED "DENNIS P. HAGAN, PS#17".

I HEREBY CERTIFY THAT A SURVEY WAS MADE OF THE PREMISES AND THAT THE ATTACHED PLAT IS CORRECT TO THE BEST OF MY KNOWLEDGE.

DATED: 3/7/89

DENNIS P. HAGAN P.S. #6817
OHIO REGISTERED SURVEYOR

REYNOLDSBURG PLANNING COMMISSION
APPROVED
DATE 3/14/89
PER
ZONING OFFICER
CITY OF REYNOLDSBURG, OHIO

TRUED
188 607 CSO