


5.001 ACRE SURVEY FOR J.L. WILCOX CO

3-41-0

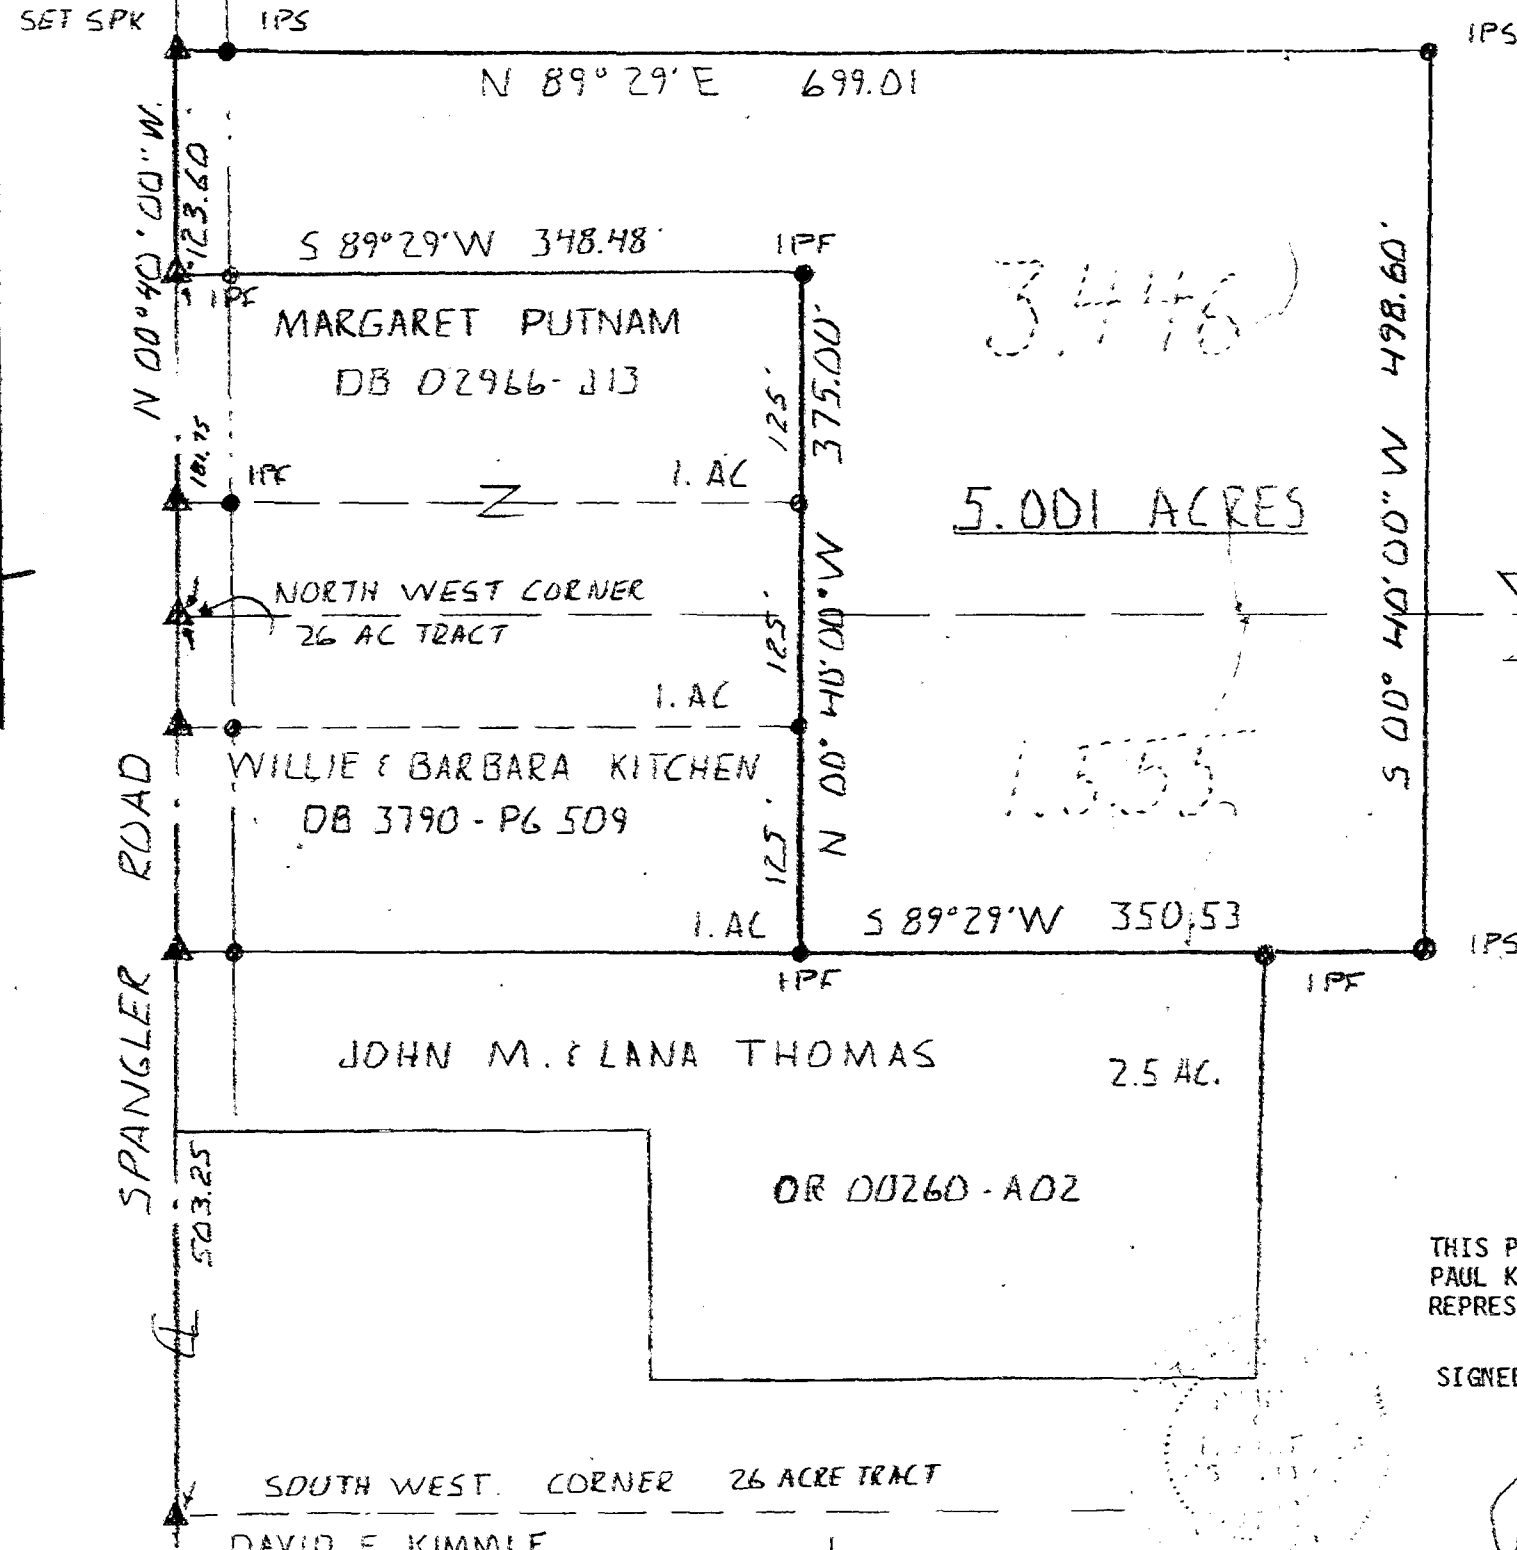

SCALE  
1" = 100'

3446

5.001 ACRES

1355

FIRST TRACT 36.75 ACRES

M. DOUGLAS MINNICH  
OFFICIAL RECORDS  
VOL 02486 PG A16

SECOND TRACT 26 ACRES

THIS PLAT WAS PREPARED FROM AN ACTUAL FIELD SURVEY MADE BY  
PAUL K. MOORE & ASSOCIATES, ON December 2, 1983, AND  
REPRESENTS THE PREMISES SHOWN HEREON.

SIGNED AT REYNOLDSBURG, OHIO, THIS 2nd DAY OF DECEMBER, 1983.

*Paul K Moore*

PAUL K. MOORE, REG

SURVEYOR NO. 5883

DAVID E. KIMMLE  
DB 3597 PG 245