

E Williams Road

126.72' Belt 240.93' 588°31'00"E 180.00' N88°31'W 1265.00'

Lillie M. Helse
10,939 AC.
OB-1238 Pg 76



E Helse Ditch
N00°13'00"W 605.36'

435.60' 34"IP
Bobby Bocook
1.80 AC
OR-25009-C-04
1025.09 AC
MON
#8820
25322775
51377775
SE Adam Creek Dkt

501°22'03"W 417.13'
588°31'00"E 180.00'
100.00'
501°22'03"W 535.60'
34"IP 60.00'
34"IP 588°31'00"E

6.471 ACRES

Ryder Truck Rental Inc.
8,8356 AC.
OR 22581-H-01

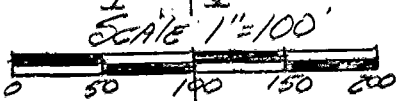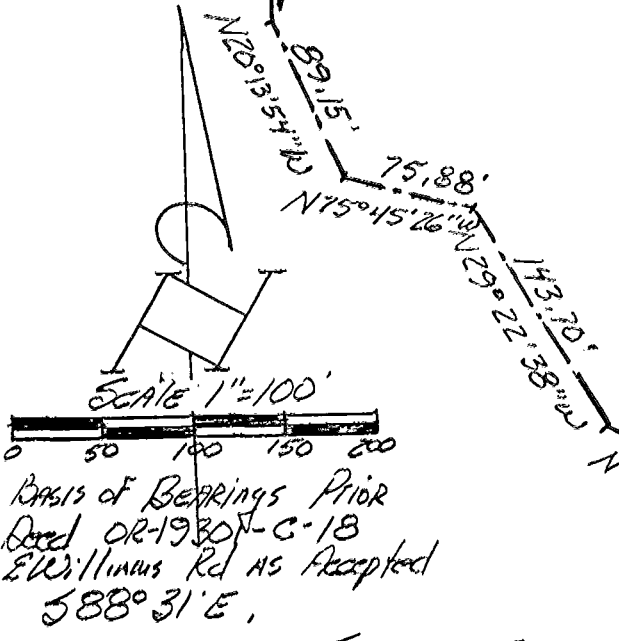

Basis of Bearings Prior
Deed OR-1930-C-18
E Williams Rd as Accepted
588°31'E

SURVEY OF 6.471 ACRES
in Sec. 13, Twp. 4, Rge. 22,
Obetz, Franklin Co.,
Ohio: FOR

A.E.N. Trucking



JP Sams Graves
14,431 AC.
OR-4518-F-09



LOUIS F. HAINES
SURVEYOR
354 KESSLER ST.
GROVEPORT, OH. 43125

Phone 837-2181

I hereby certify that the plat shown hereon was prepared from
an actual field survey, under my supervision and that said plat
correctly represents said survey.

DATE: 6-17-94 SIGNED: [Signature]

Rev. 6-24-94
Rev. 9-16-94

0-24-B