HOCKADEN-LIPES-ROUSCULP, INC.
CONSULTING ENGINEERS
[illegible] ST.
COLUMBUS, OHIO

N-122-E

LOT NO. Lots all of lot 1585 and part of lot 1584 ADDITION BEACHLIGHT ESTATES NO. 8
or or
PARCEL NO. ..... TOWNSHIP .....

PLAT BOOK NO. 42 PAGE NO. 52-53 FRANKLIN COUNTY RECORDER'S RECORDS

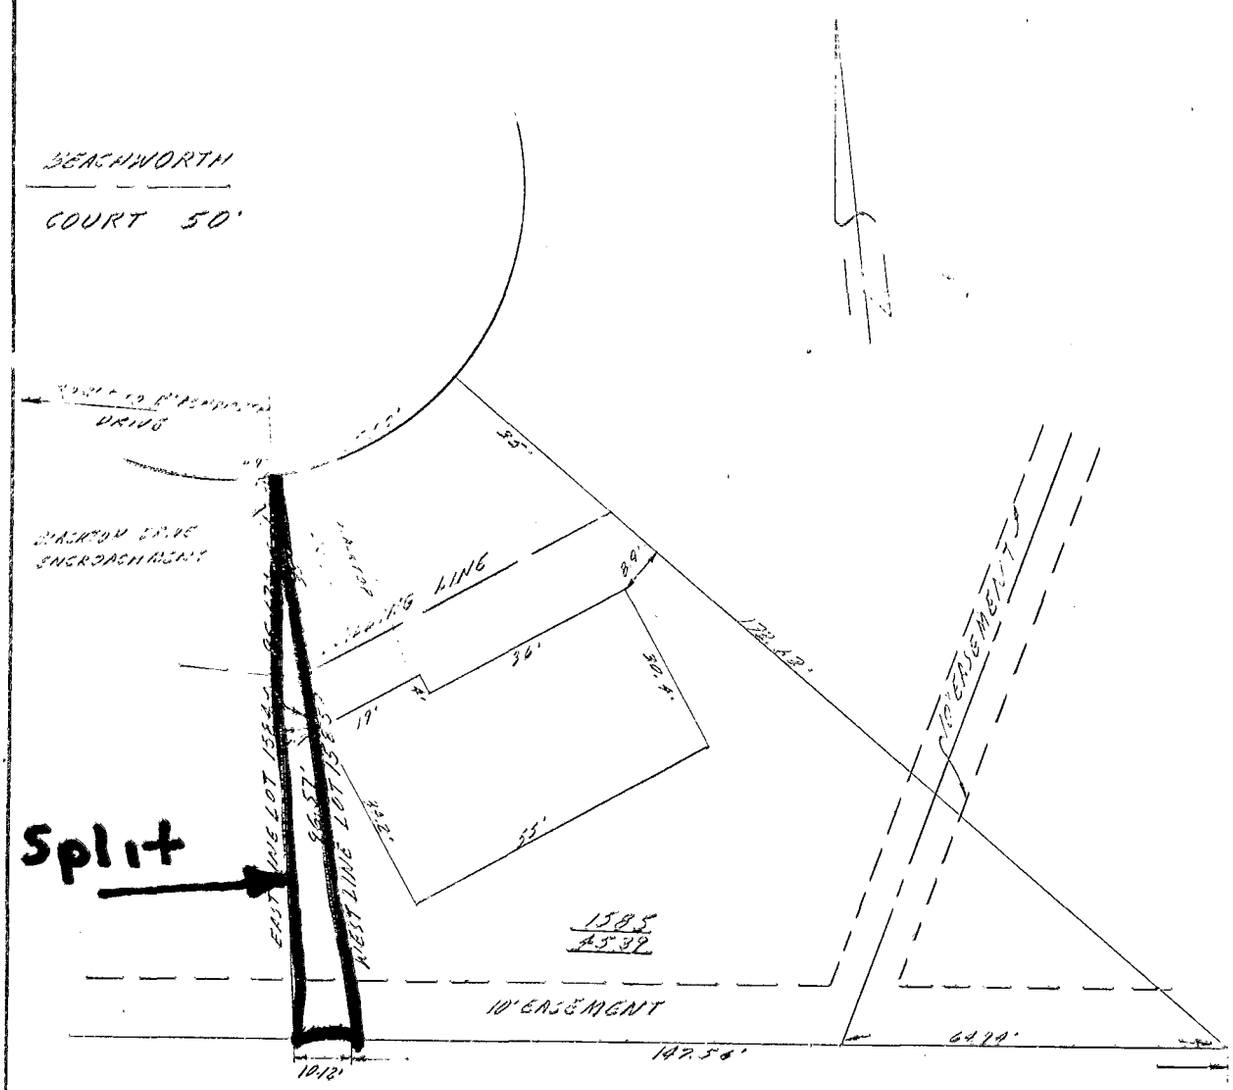

N-122-E

We hereby certify that the foregoing plat was prepared from an actual survey of the premises and correctly shows the location of the building or buildings including any drives. This plat is for Mortgage and Title Insurance purposes only.

SCALE 1" = 50'

SURVEYED	DRAWN	CHECKED

DATE:

REVISED DATES	ORDER NUMBERS

HOCKADEN-LIPES-ROUSCULP, INC.

By .....
Registered Surveyor