


87856925  
8766925

EXHIBIT "A"  
Page 3 of 3

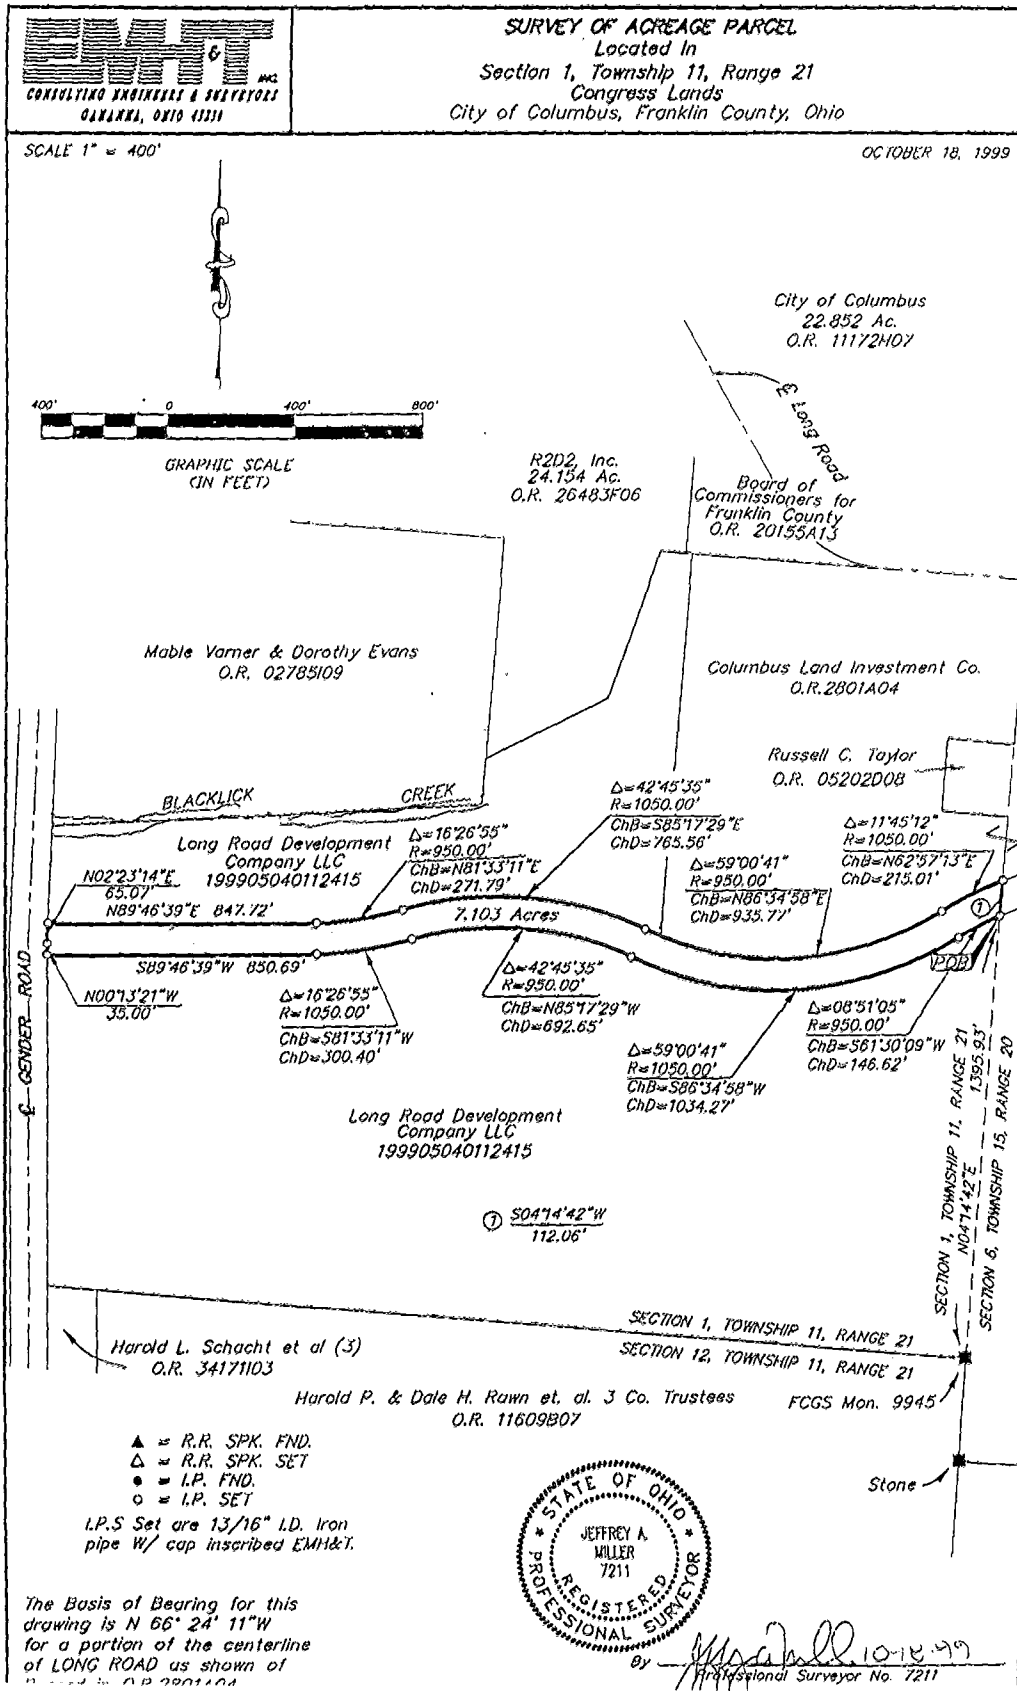

SIGNATURE OF GRANTEE OR REPRESENTATIVE

COUNTY AUDITOR

DATE

C-43-A  
Marrison Trap