BEING PART OF THE N.W. QTR. OF SEC. 28, TWP. 11, R. 21,
MATHEWS SURVEY, GROVEPORT, OHIO

FOR

DOLLAR SAVINGS

DB 1255 Page 81
Scale 1" = 20.'

9·27·'73
REVISED OCT. 1, 1973

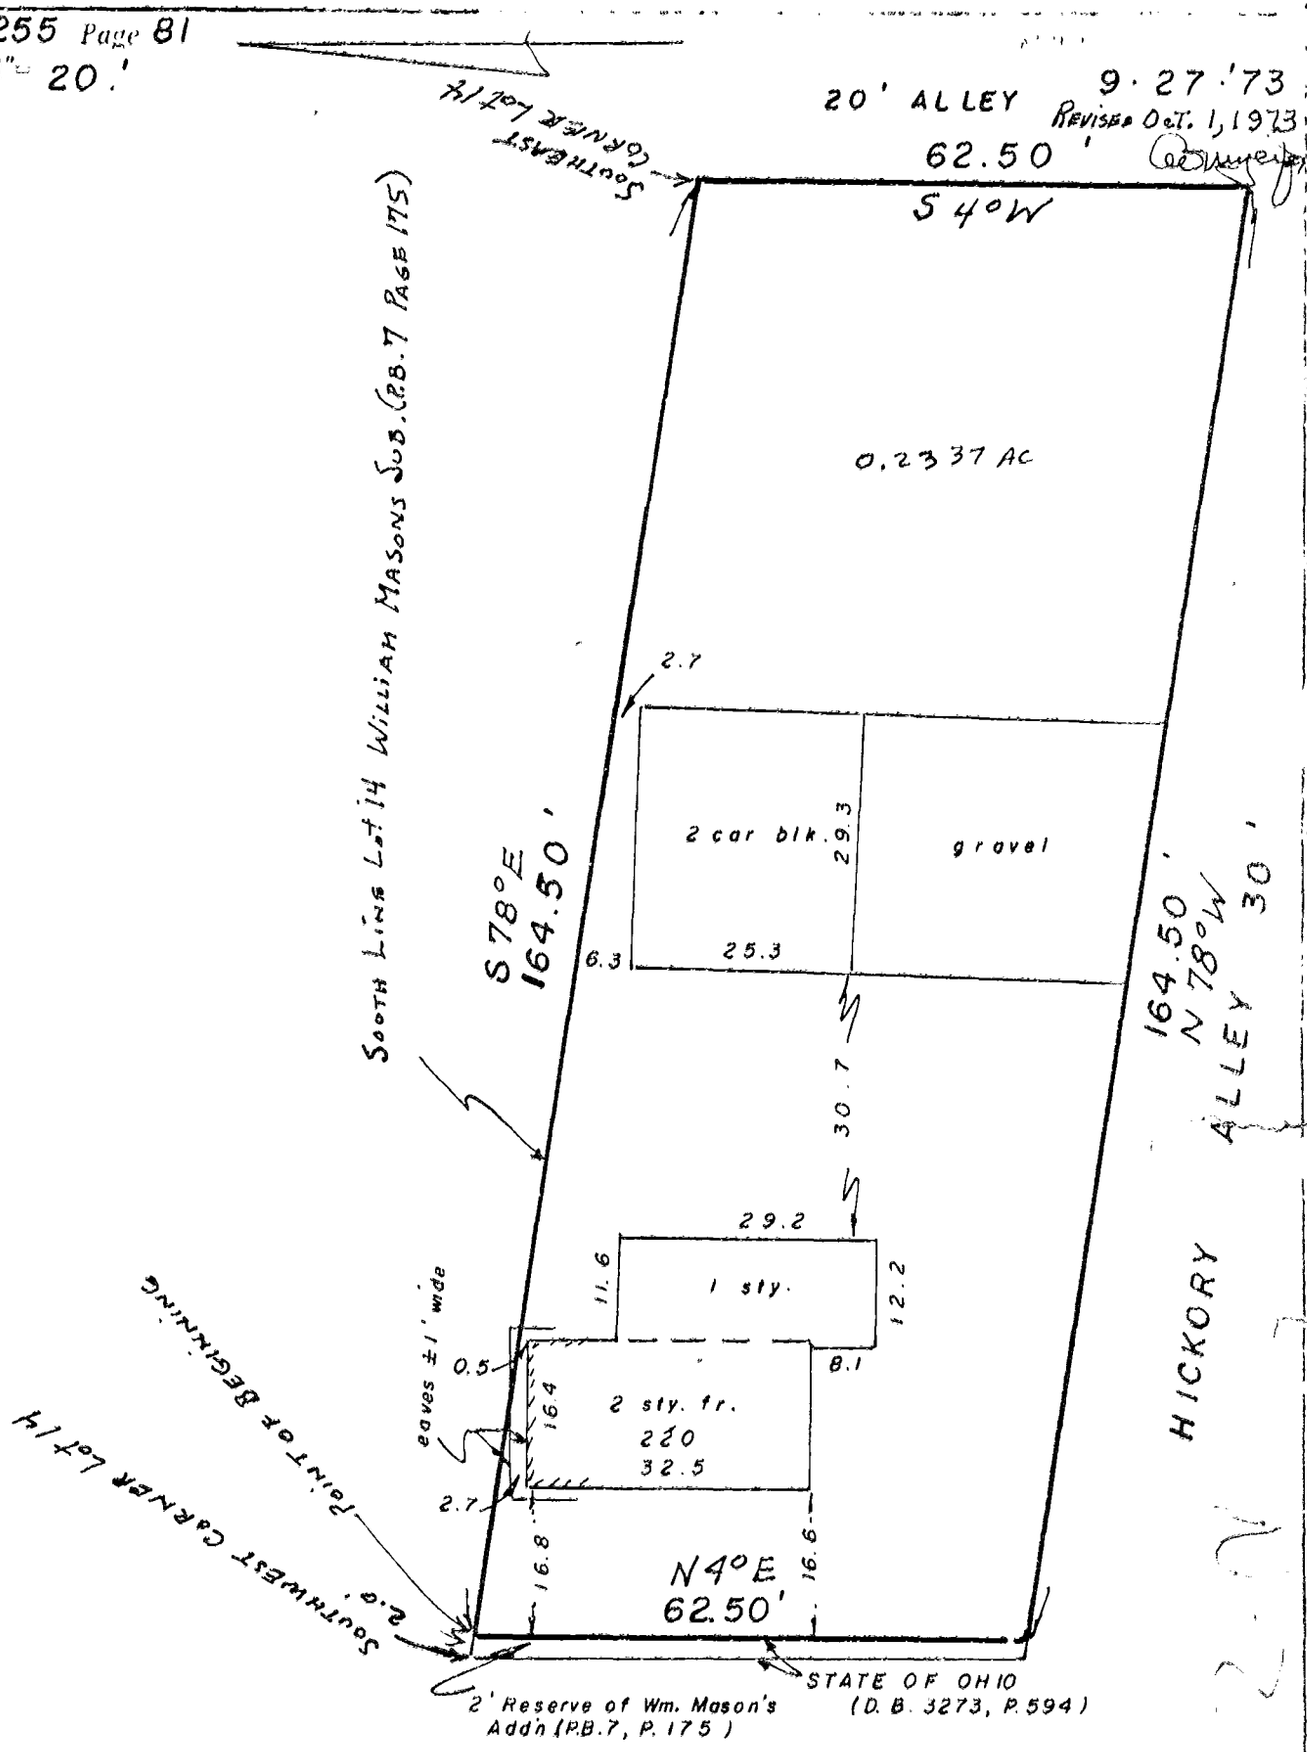

We hereby certify that the foregoing plat was prepared from an actual survey of the premises. No side line of principal building is less than dimension shown. Iron pins not set unless indicated thus ○. For Mortgage Loan & Title Insurance purposes only.

MYERS SURVEYING CO.
BY Albert C. Myers Jr.
Registered Surveyor

M A LEE

F | D | L | C