Louis F Haines & Associates

SURVEYORS

354 Kessler Street
Groveport, Ohio
Phone 836-5[illegible]1

O-95-A

SURVEY FOR

Guy & Arthur Hill

O-[illegible]

BEING [illegible] ACRES IN THE [illegible]
SEC. [illegible], TWP. [illegible], R. [illegible], MARION TOWNSHIP,
FRANKLIN COUNTY, OHIO.

P.B Page Franklin Co. Rec. Off

Scale 1" = [illegible]' DATE JUNE 3[illegible] 1967

O-45 A MADISON

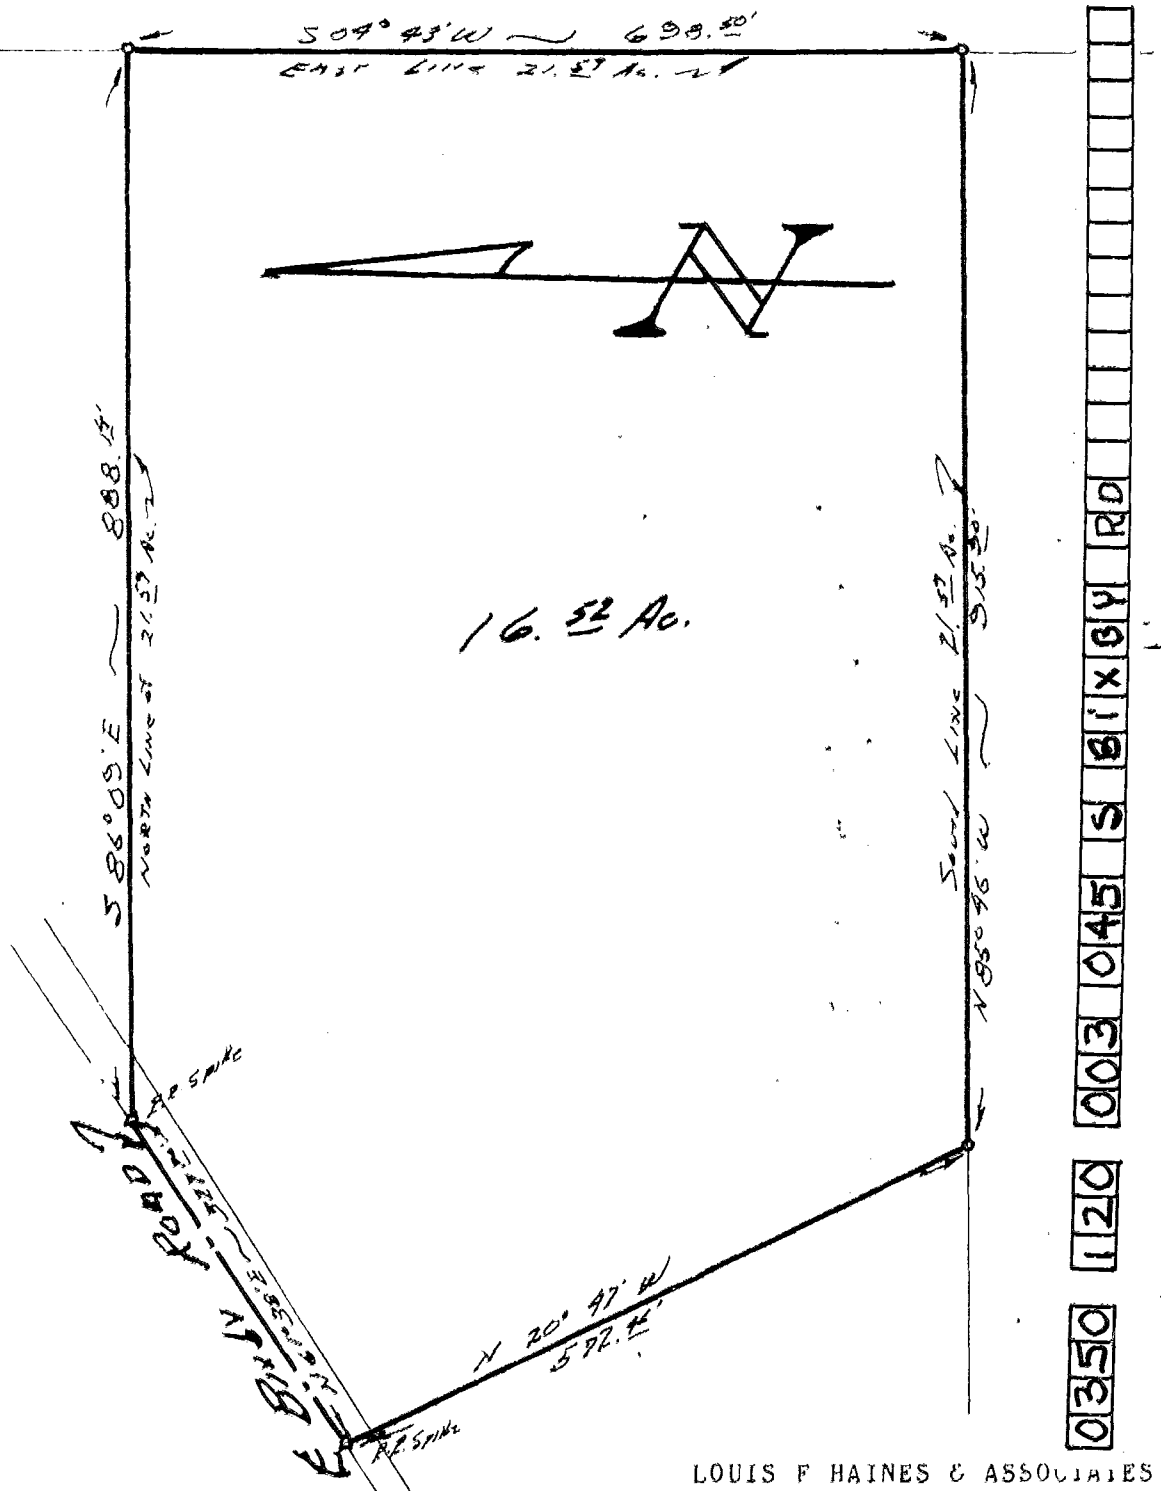

LOUIS F HAINES & ASSOCIATES

BY Louis F. Haines
Registered Surveyor #[illegible]

ORDER #

We hereby certify that the foregoing plat was prepared from an actual survey of the premises. No side line of principal building is less than dimension shown. Iron pins not set unless indicated thus —O— For Mortgage Loan & Title Insurance purposes only.


863576800

Hill