MYERS SURVEYING CO.
2740 East Mt. Vern, Columbus 5 (Bexley), Ohio

PART OF LOT 1 HARRIET ADD'N. MADISON TWP., FRANKLIN CO., OHIO

FOR

MR. WILLIAM SOLOMON

F.B. 27 Page 78
Scale 1" = 25'

Franklin Co. Rec. Office
10 · 27 · '67

N-4-B

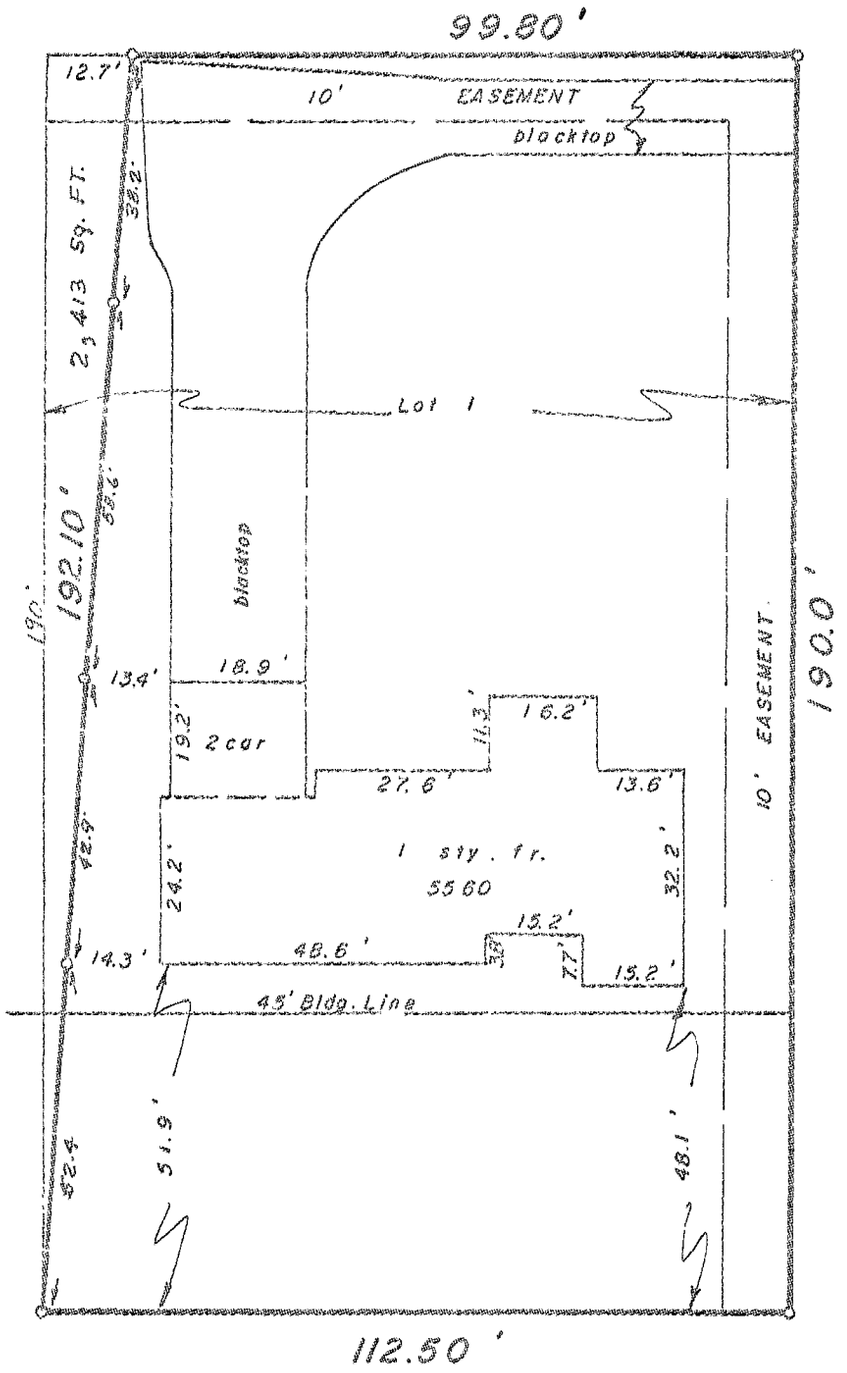

N-4-B

FRANKLIN COUNTY
DIV. OF BUILDING REGULATION
OCT 30 1967
CHIEF BUILDING INSPECTOR
By Neda Bryant Chamnor

We hereby certify that the foregoing plat was prepared from an actual survey of the premises. No side line of principal building is less than dimension shown. Iron pins not set unless indicated thus —0—.

MYERS SURVEYING CO.
By [signature]
Registered Surveyor