85356700
85356675
32201-A

MADISON Twp.

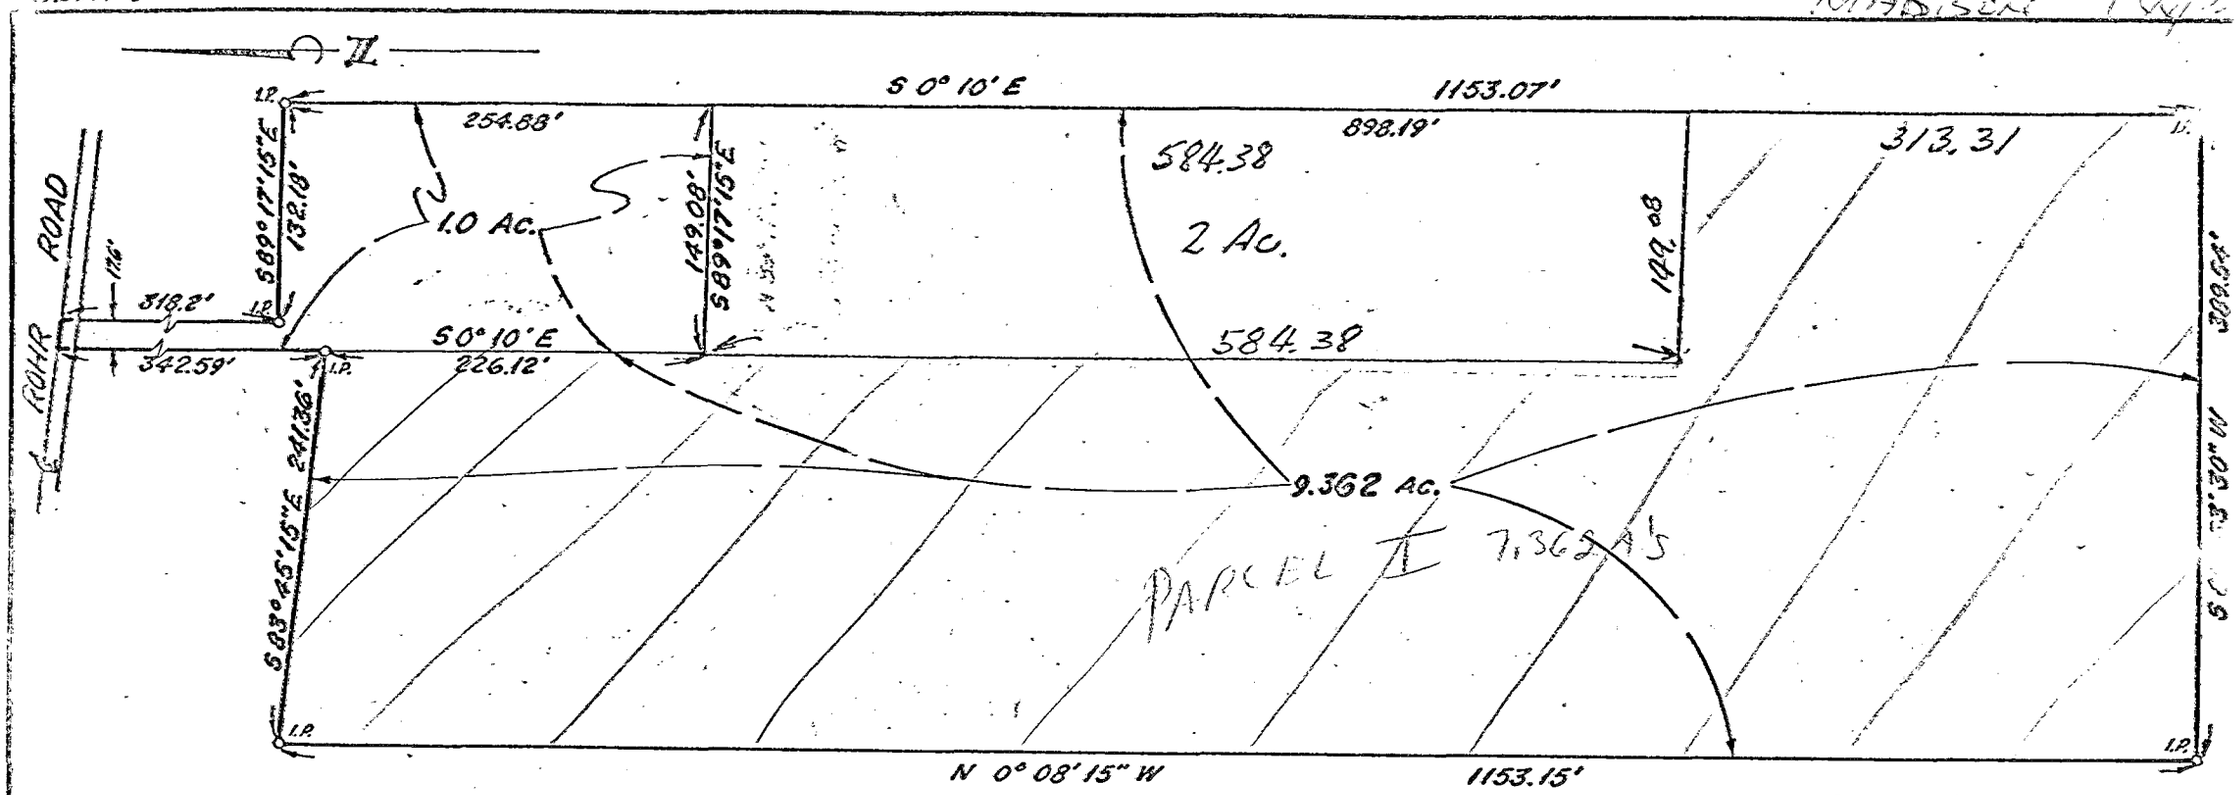

SURVEY OF 10.362 ACRE TRACT
PT. HALF SEC. 32, TWP. 11, MATTHEWS SURVEY
OF CONGRESS LANDS
MADISON TWP., FRANKLIN CO., OHIO
for

FRANCIS KOVACS

SCALE: 1" = 100' APRIL 1966

THE JENNINGS - LAWRENCE CO.
Civil Engineers and Surveyors
355 Buttles Avenue
Columbus 15, Ohio

By Lawrence G. Lawrence

95- 3870 170 089 068 S ROHR RD 1966 0472 001

ev. Aug. 12, 66
revised 6-7-66