

1/8" = 30'

Winchester Village
Plat Book 45, Page 36

63 64 65 66 67 68 69 70 71

Boundary and Topographic Survey

Reserve A of
Winchester Village
Plat Book 45, Page 36

Village of Canal Winchester, Franklin County, Ohio


Reserve A

1.5368 Acres

1.0984 Acres

Chesterville Drive

Waterloo Street

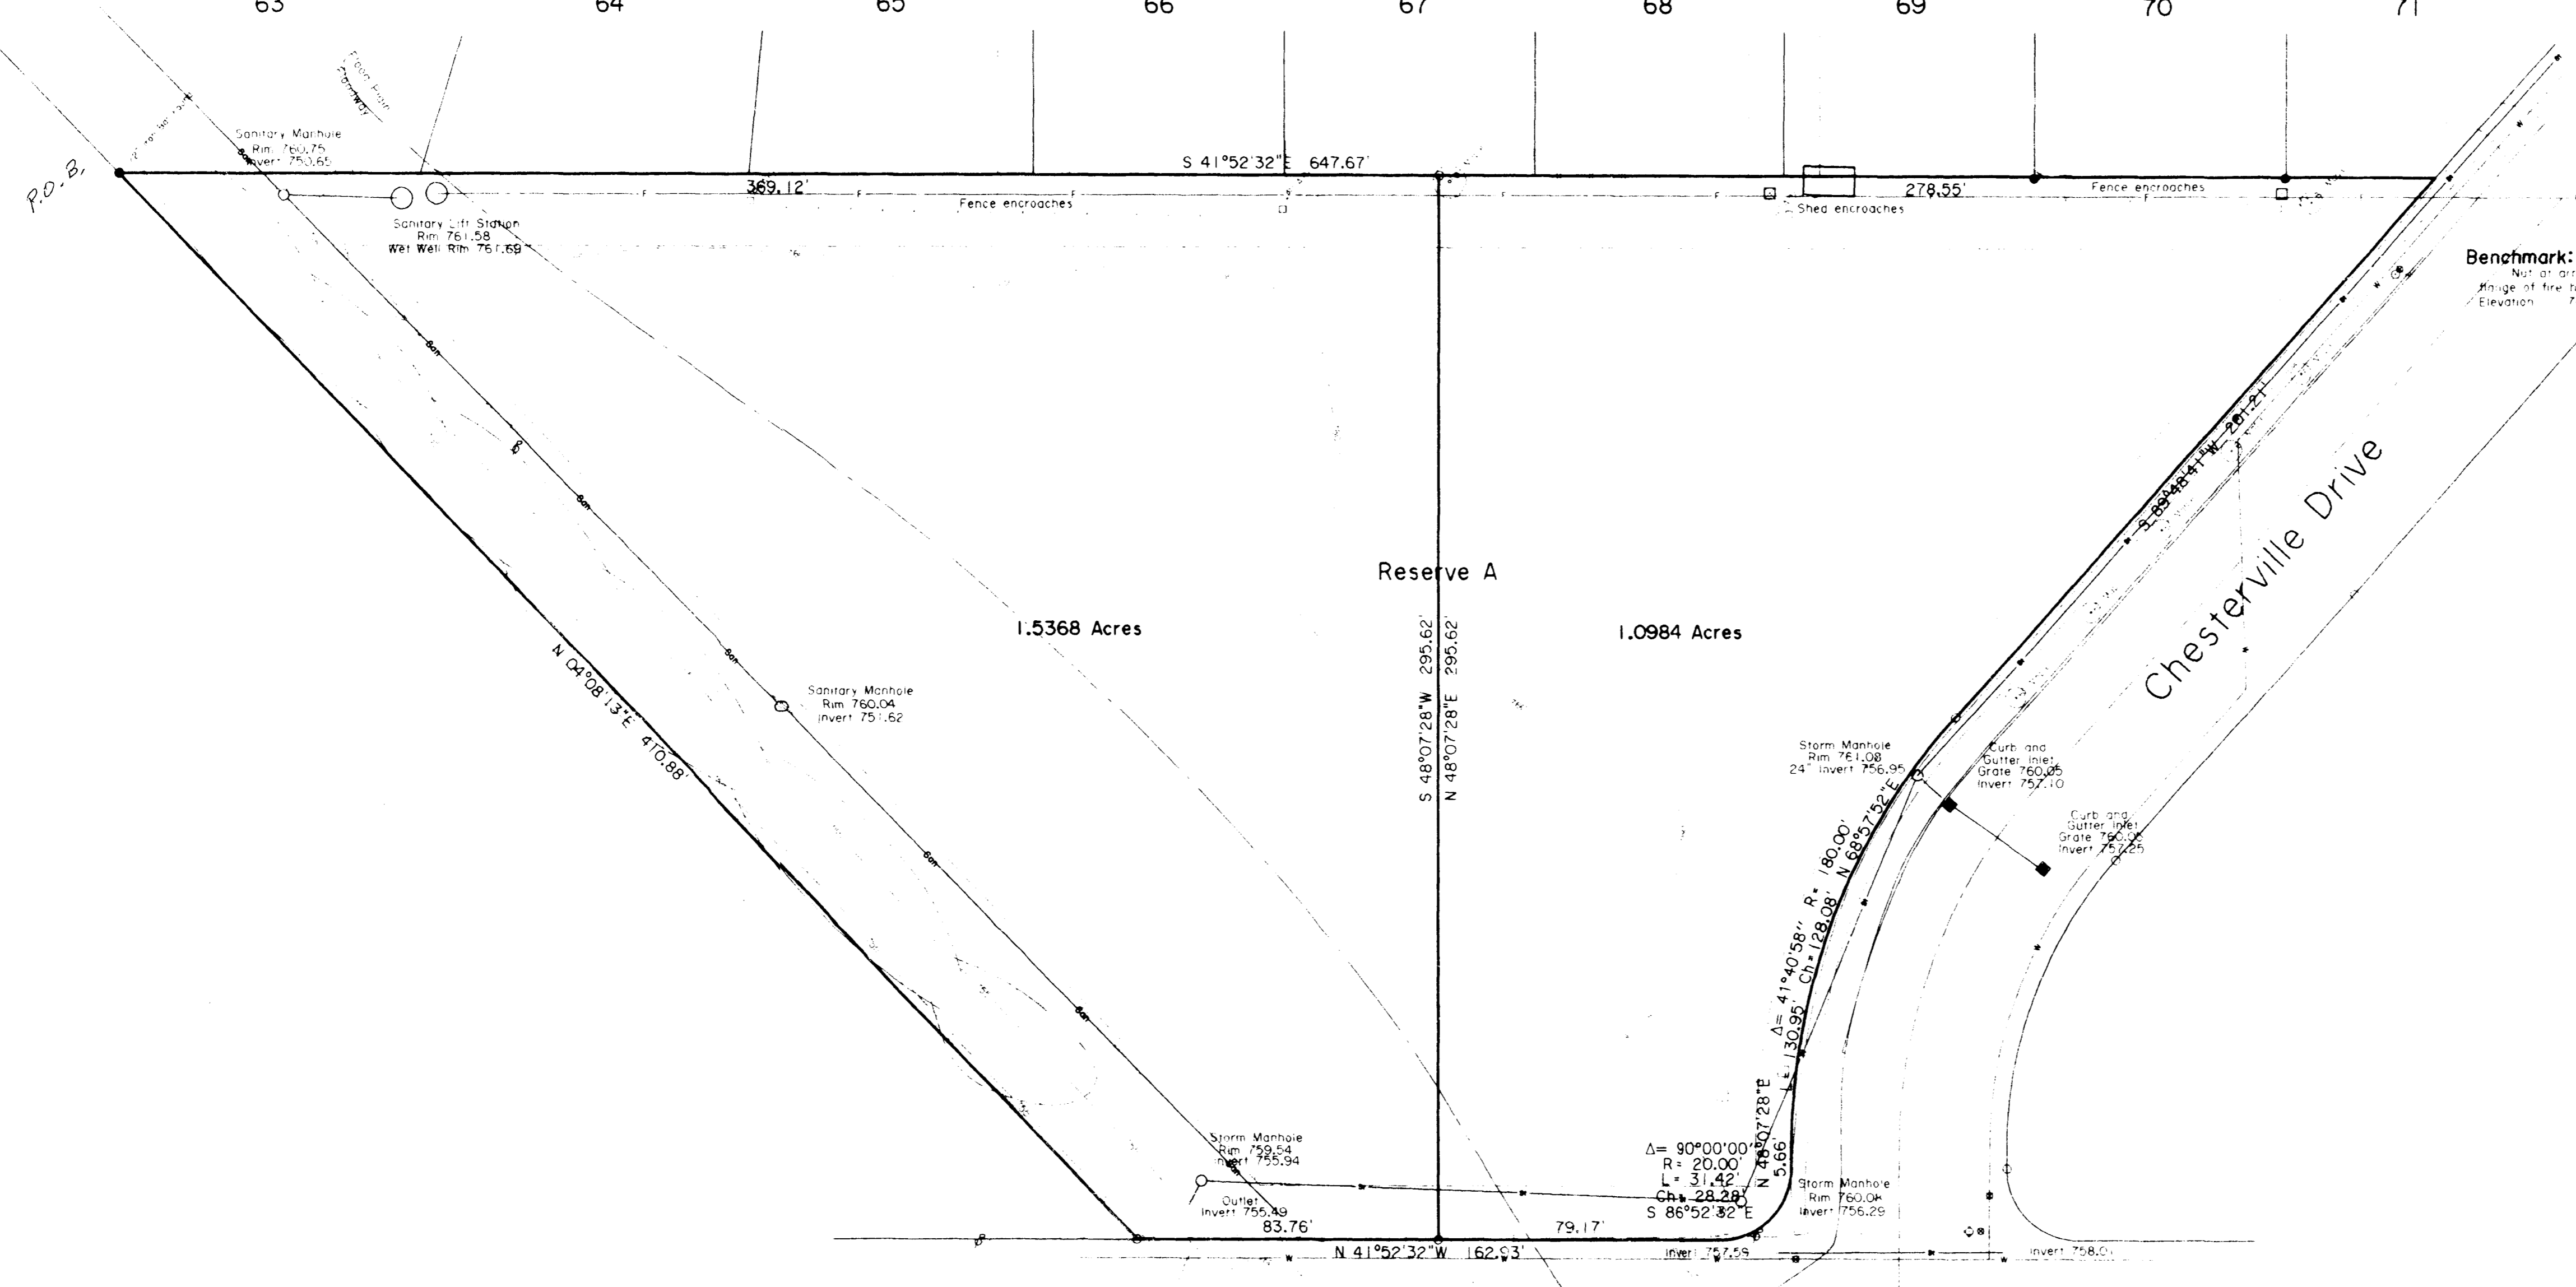



TO ALL PARTIES INTERESTED IN TITLE TO THE PREMISES SURVEYED:

I, Ronald G. Rudnik, State of Ohio, Licensed Professional Surveyor, No. 4723, do hereby certify that the foregoing is a true and correct copy of the original survey as shown to me by the owner of the premises surveyed.

Ronald G. Rudnik P.S. 4723

Date 2-10-99

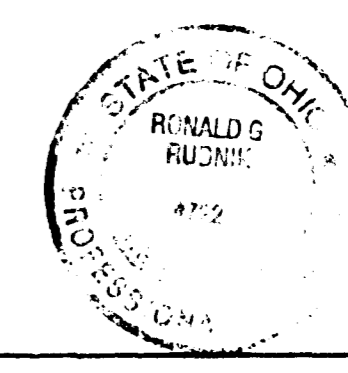

AHLERS, MOE & ASSOC. INC.
Engineers & Surveyors
360 West Waterloo Street
Canal Winchester, Ohio 43110
(614) 837-1178

UTILITY WARNING

The underground utilities shown on this plan were located from field surveys, information and existing drawings. The Surveyor makes no guarantee that the underground utilities shown comprise all such utilities in the area. It is the responsibility of the contractor to locate all utilities shown on the plan and to mark them accordingly. The Surveyor is not responsible for any damage to or destruction of any underground utility.