
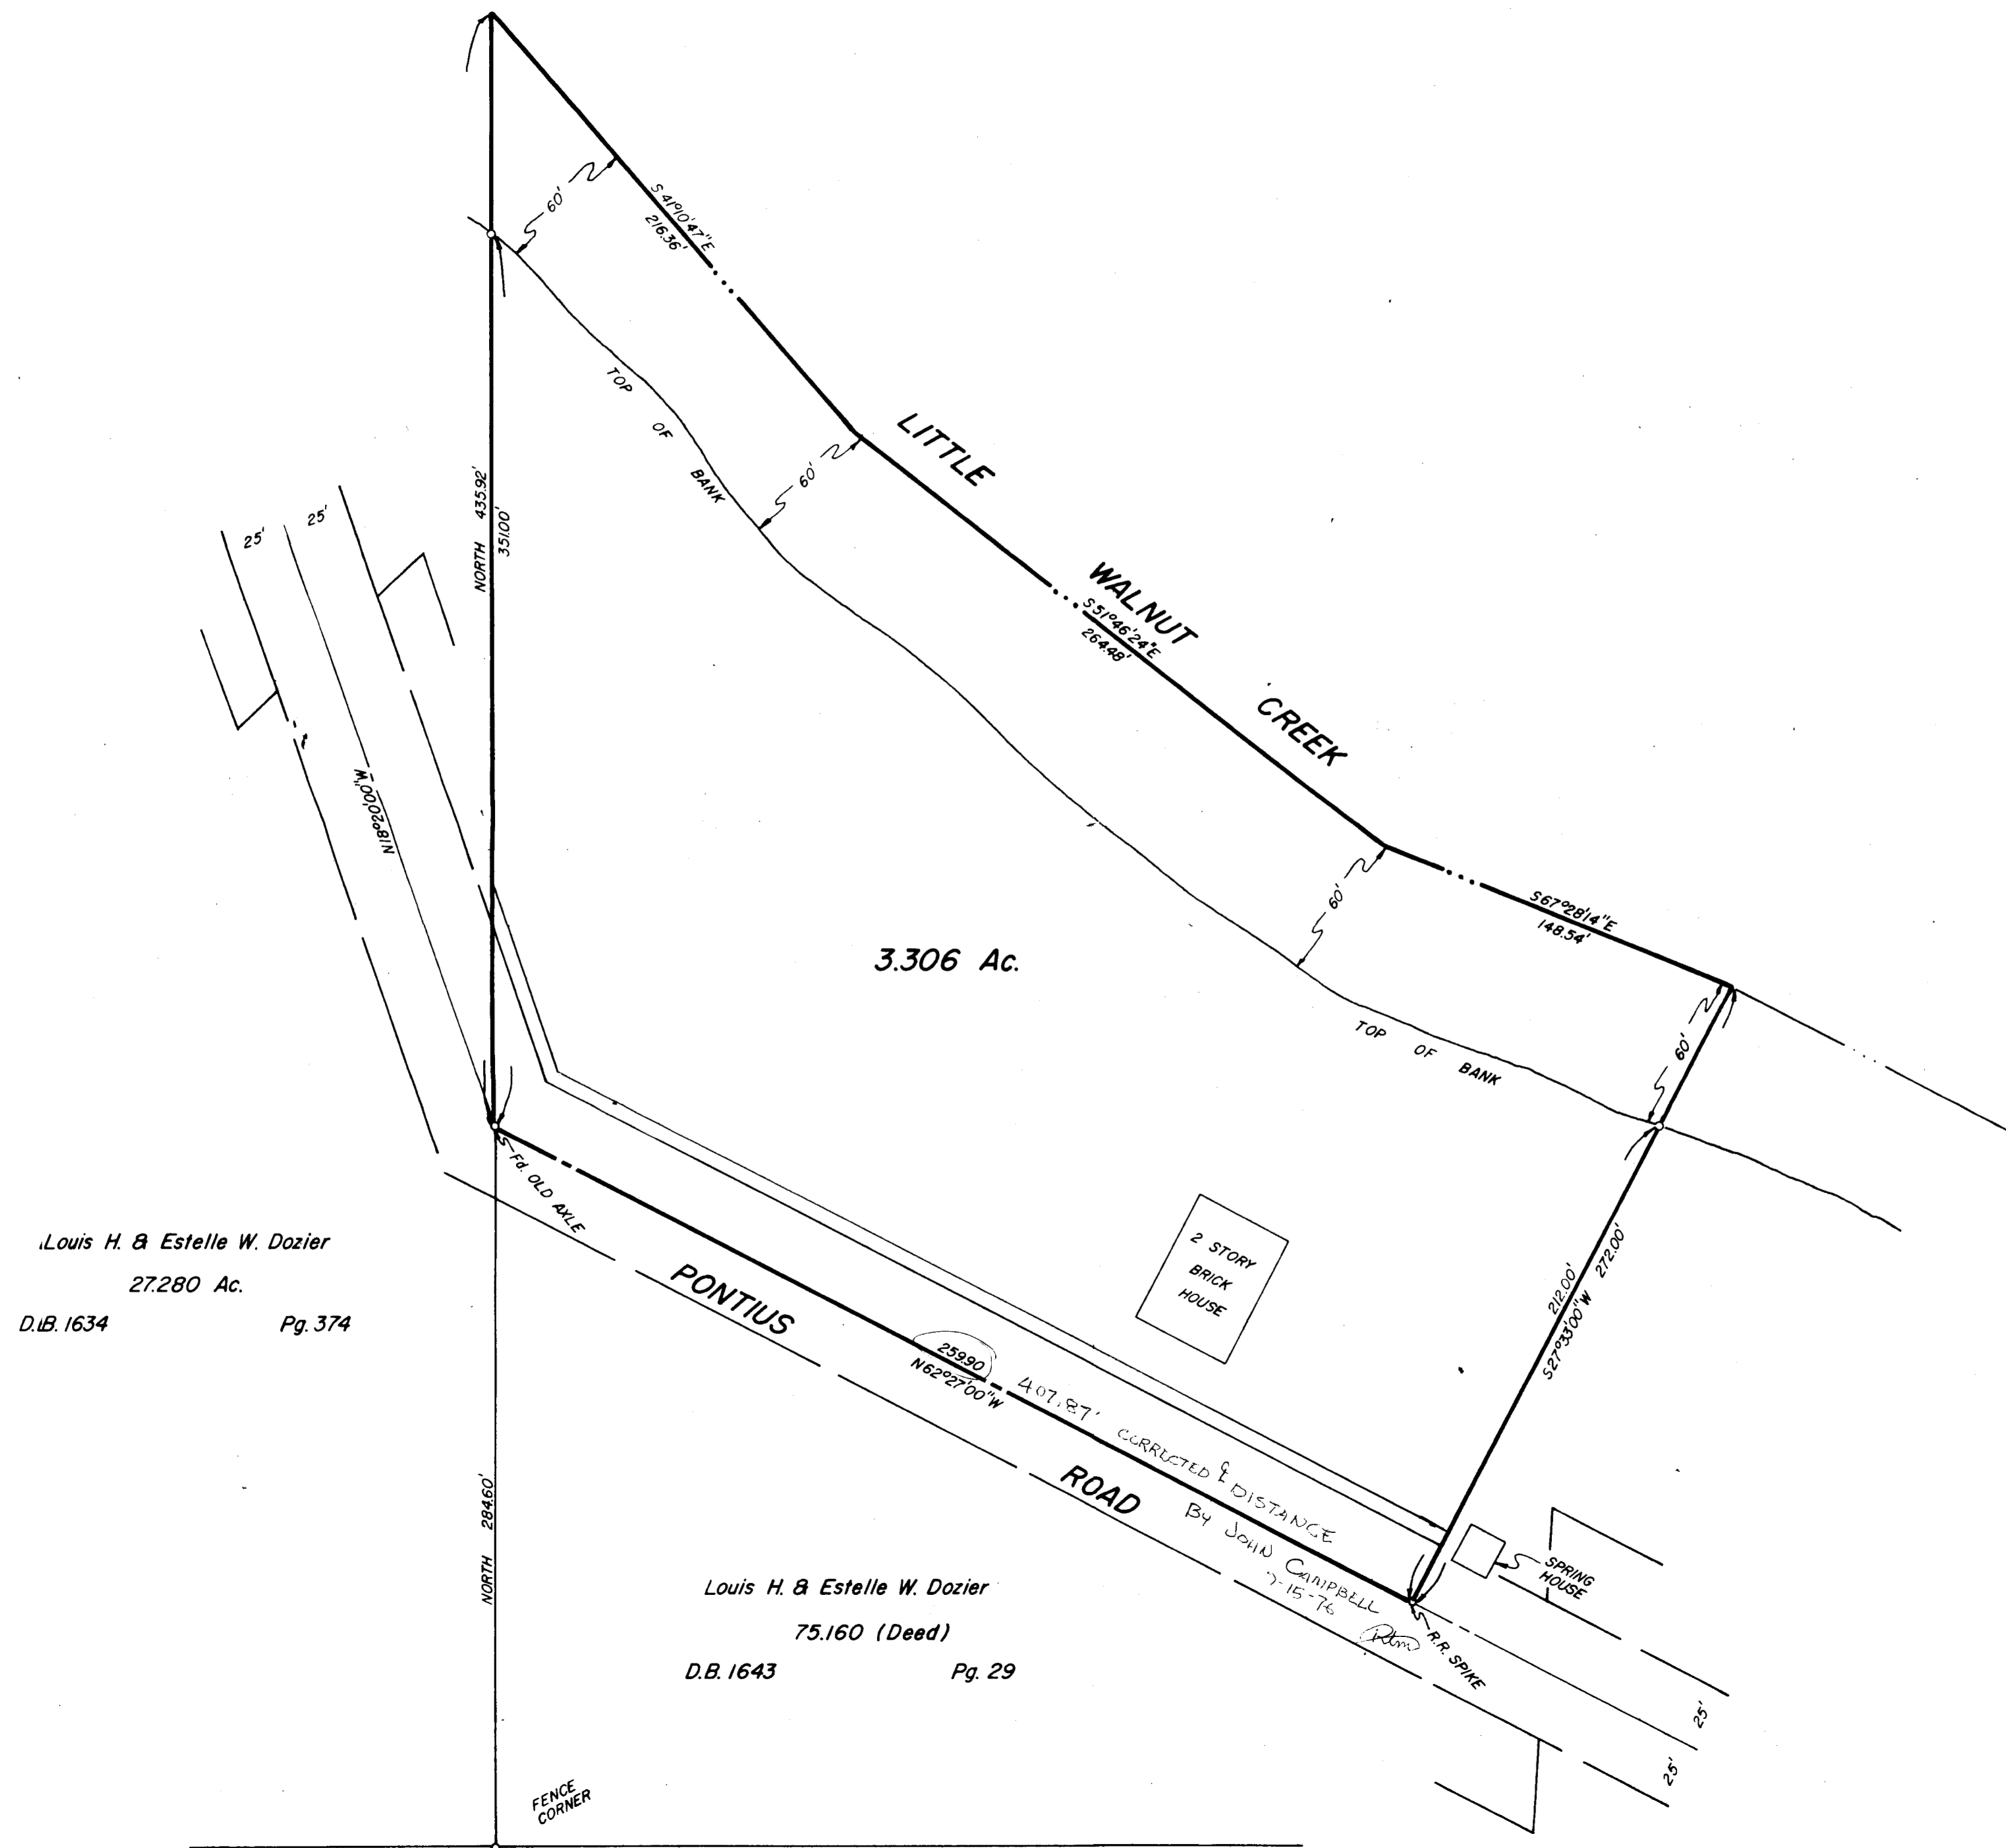


0-47-D

# SURVEY OF 3.306 ACRE TRACT

Located In Section 5, Township 10,  
Range 21, Congress Lands,  
Madison Township Franklin County, Ohio

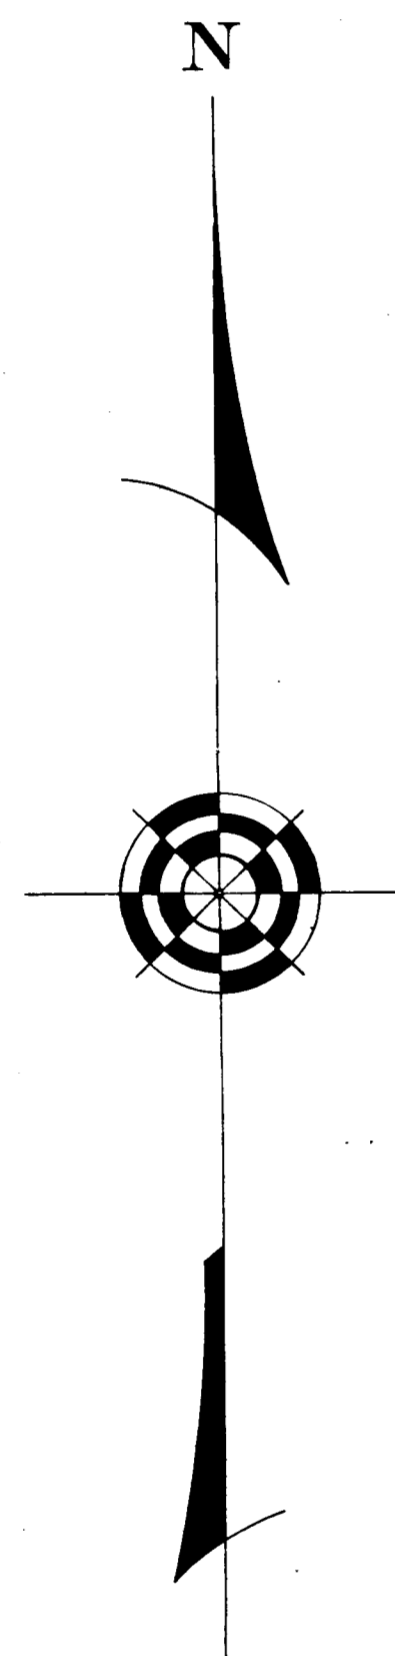

Louis H. & Estelle W. Dozier  
27.280 Ac.  
D.B. 1634 Pg. 374

Louis H. & Estelle W. Dozier  
75.160 (Deed)  
D.B. 1643 Pg. 29

SURVEYED & PLATTED  
BY  
EVANS, MECHWART, HAMBLETON & TILTON, INC.  
CONSULTING ENGINEERS & SURVEYORS  
GAHANNA, OHIO

By John W. Campbell  
Registered Surveyor No. 3185  
SCALE: 1"=50'      JULY 1, 1976      ○ = IRON PIN

3550 120 067 1100 6 PONTIUS RD 1976 0477 030