


Richardson Road

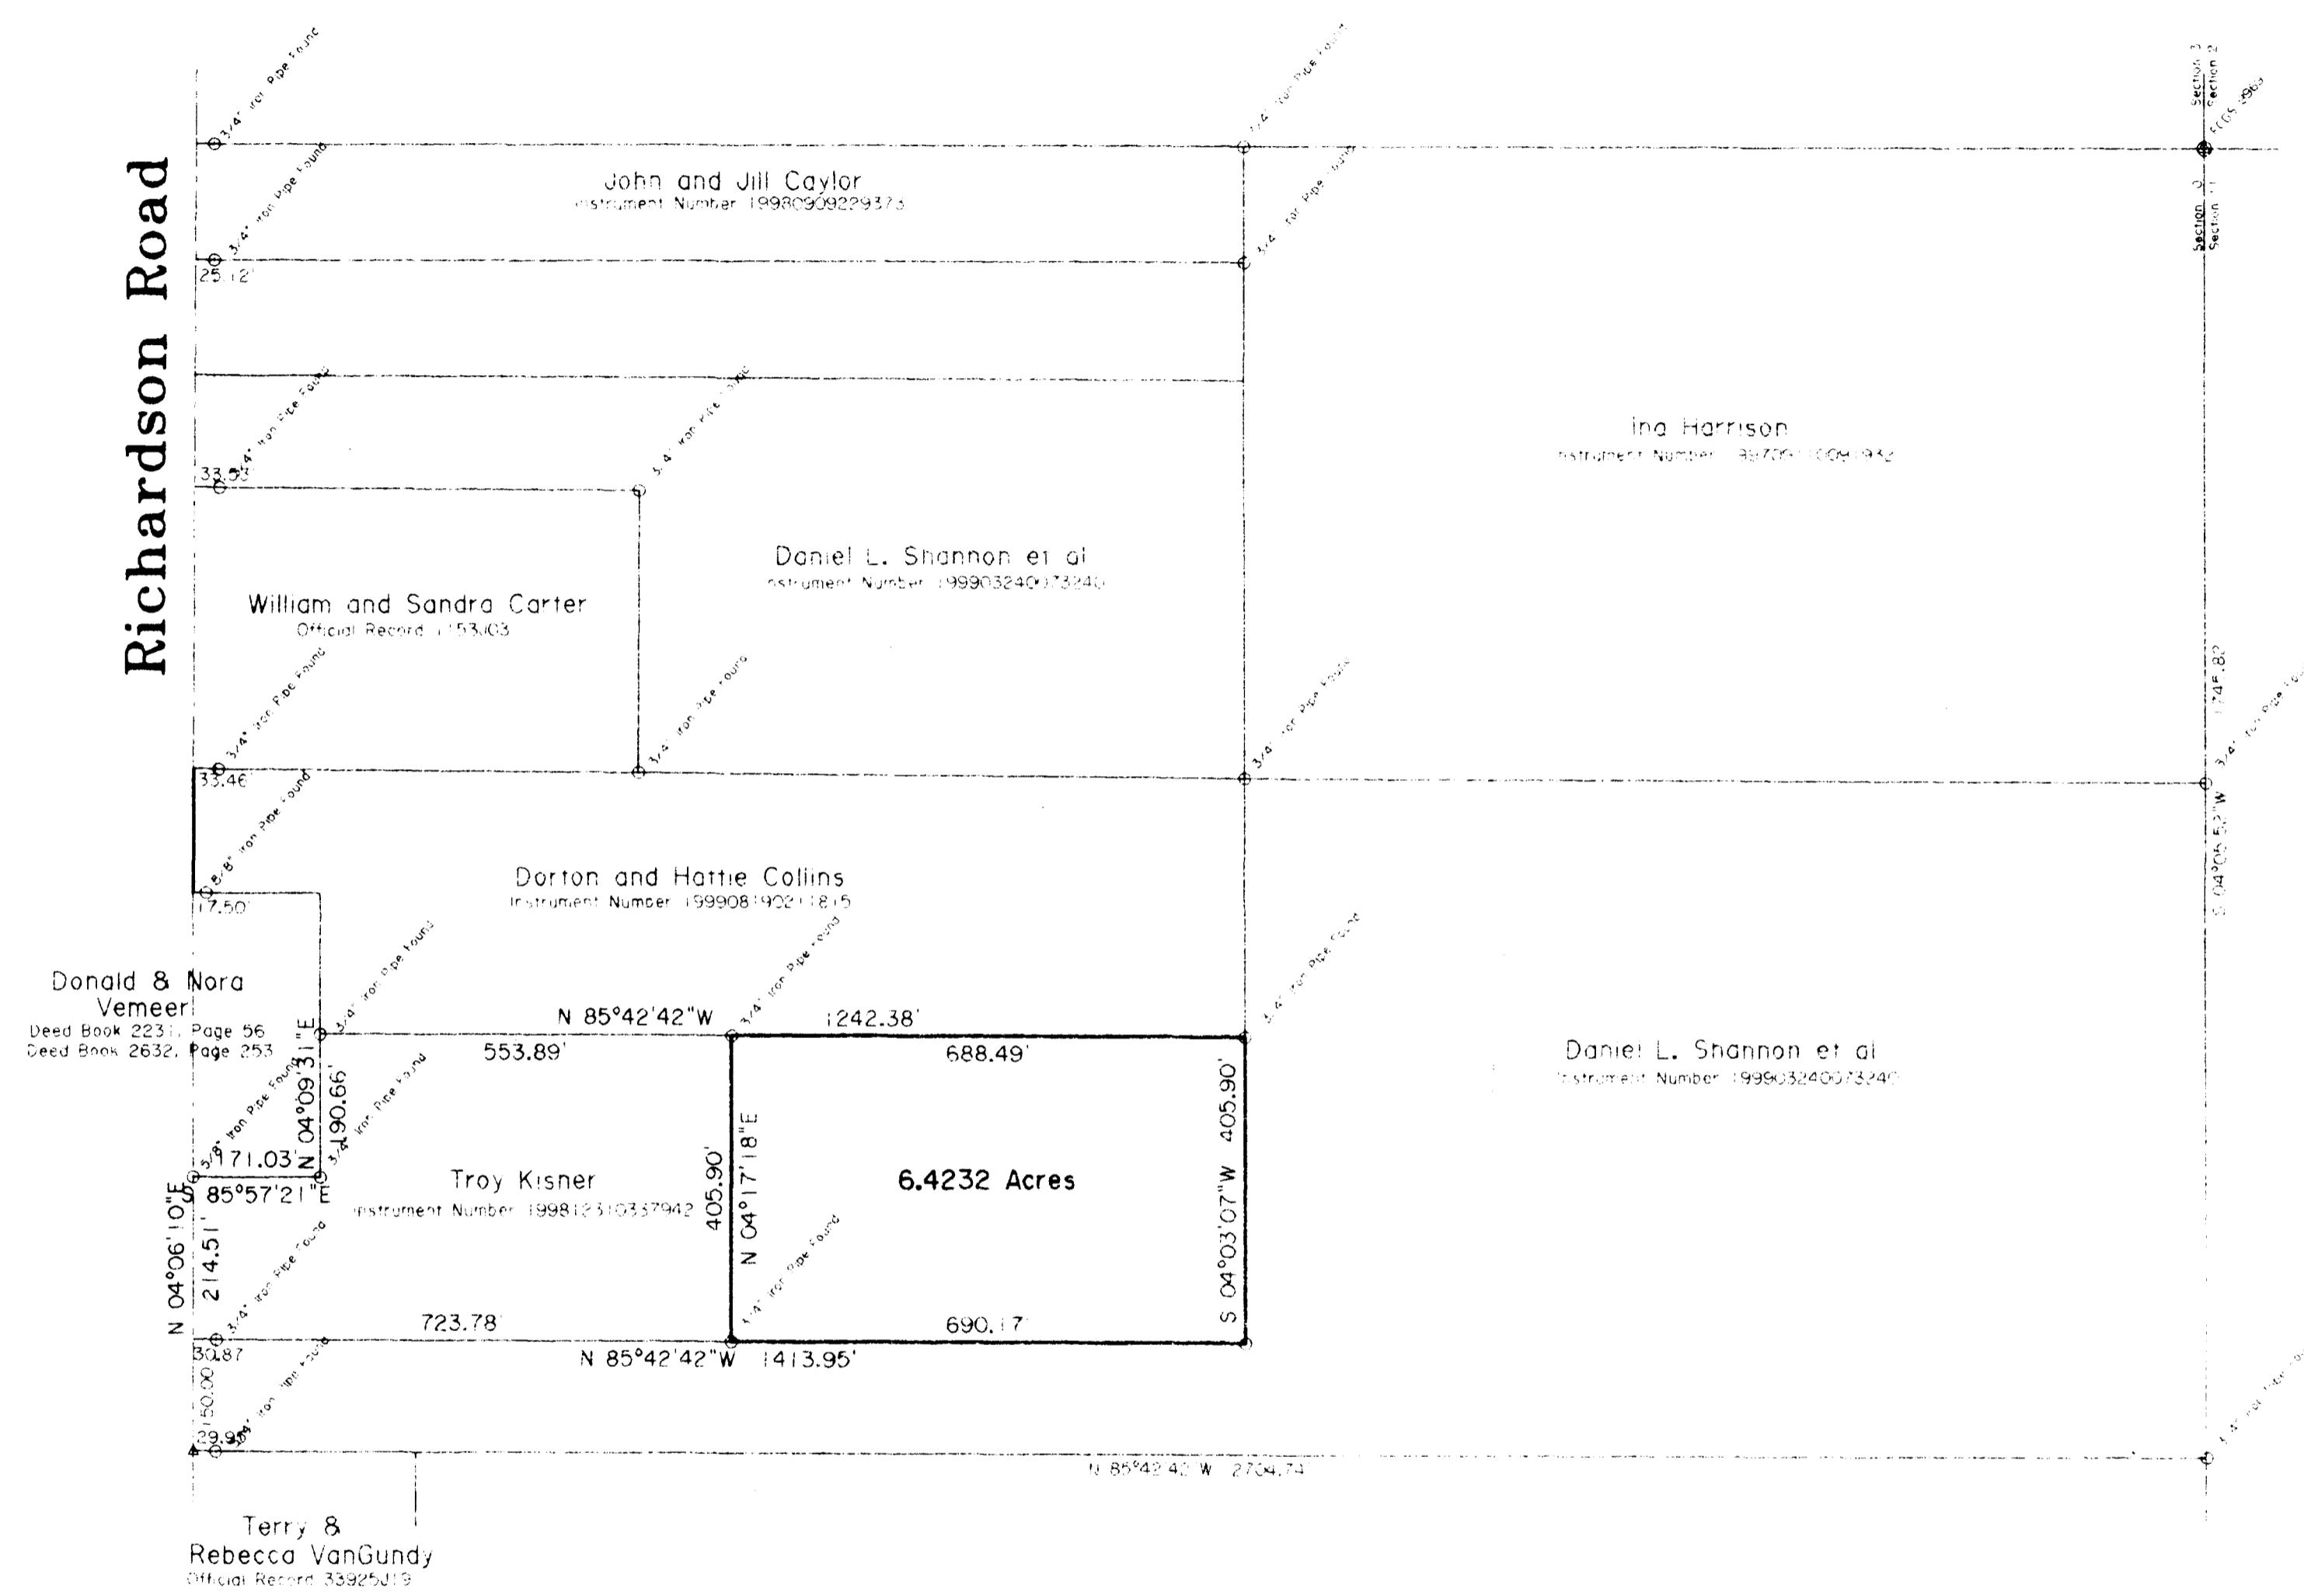


TO ALL PARTIES INTERESTED IN TITLE TO THE PREMISES SURVEYED:



Ronald G. Ruder, S.S. 1273

Date 2-9-00

6.4232 Acre Cutout		
Section 10, Township 10 North, Range 21 West of the Buckingham Survey of the Congress Lands, Madison Township, Franklin County, Ohio		
D.B.	Page	
P.B.	Page	
Scale:	1" = 200'	
Date:	February 7, 2000	
Drawn By:	RGR	
Ahlers, Moe & Assoc., Inc. Engineers & Surveyors 360 West Waterloo Street P.O. Box 2 Canal Winchester, Ohio 43110 (614) 837-1178		Job No.: 00-0210