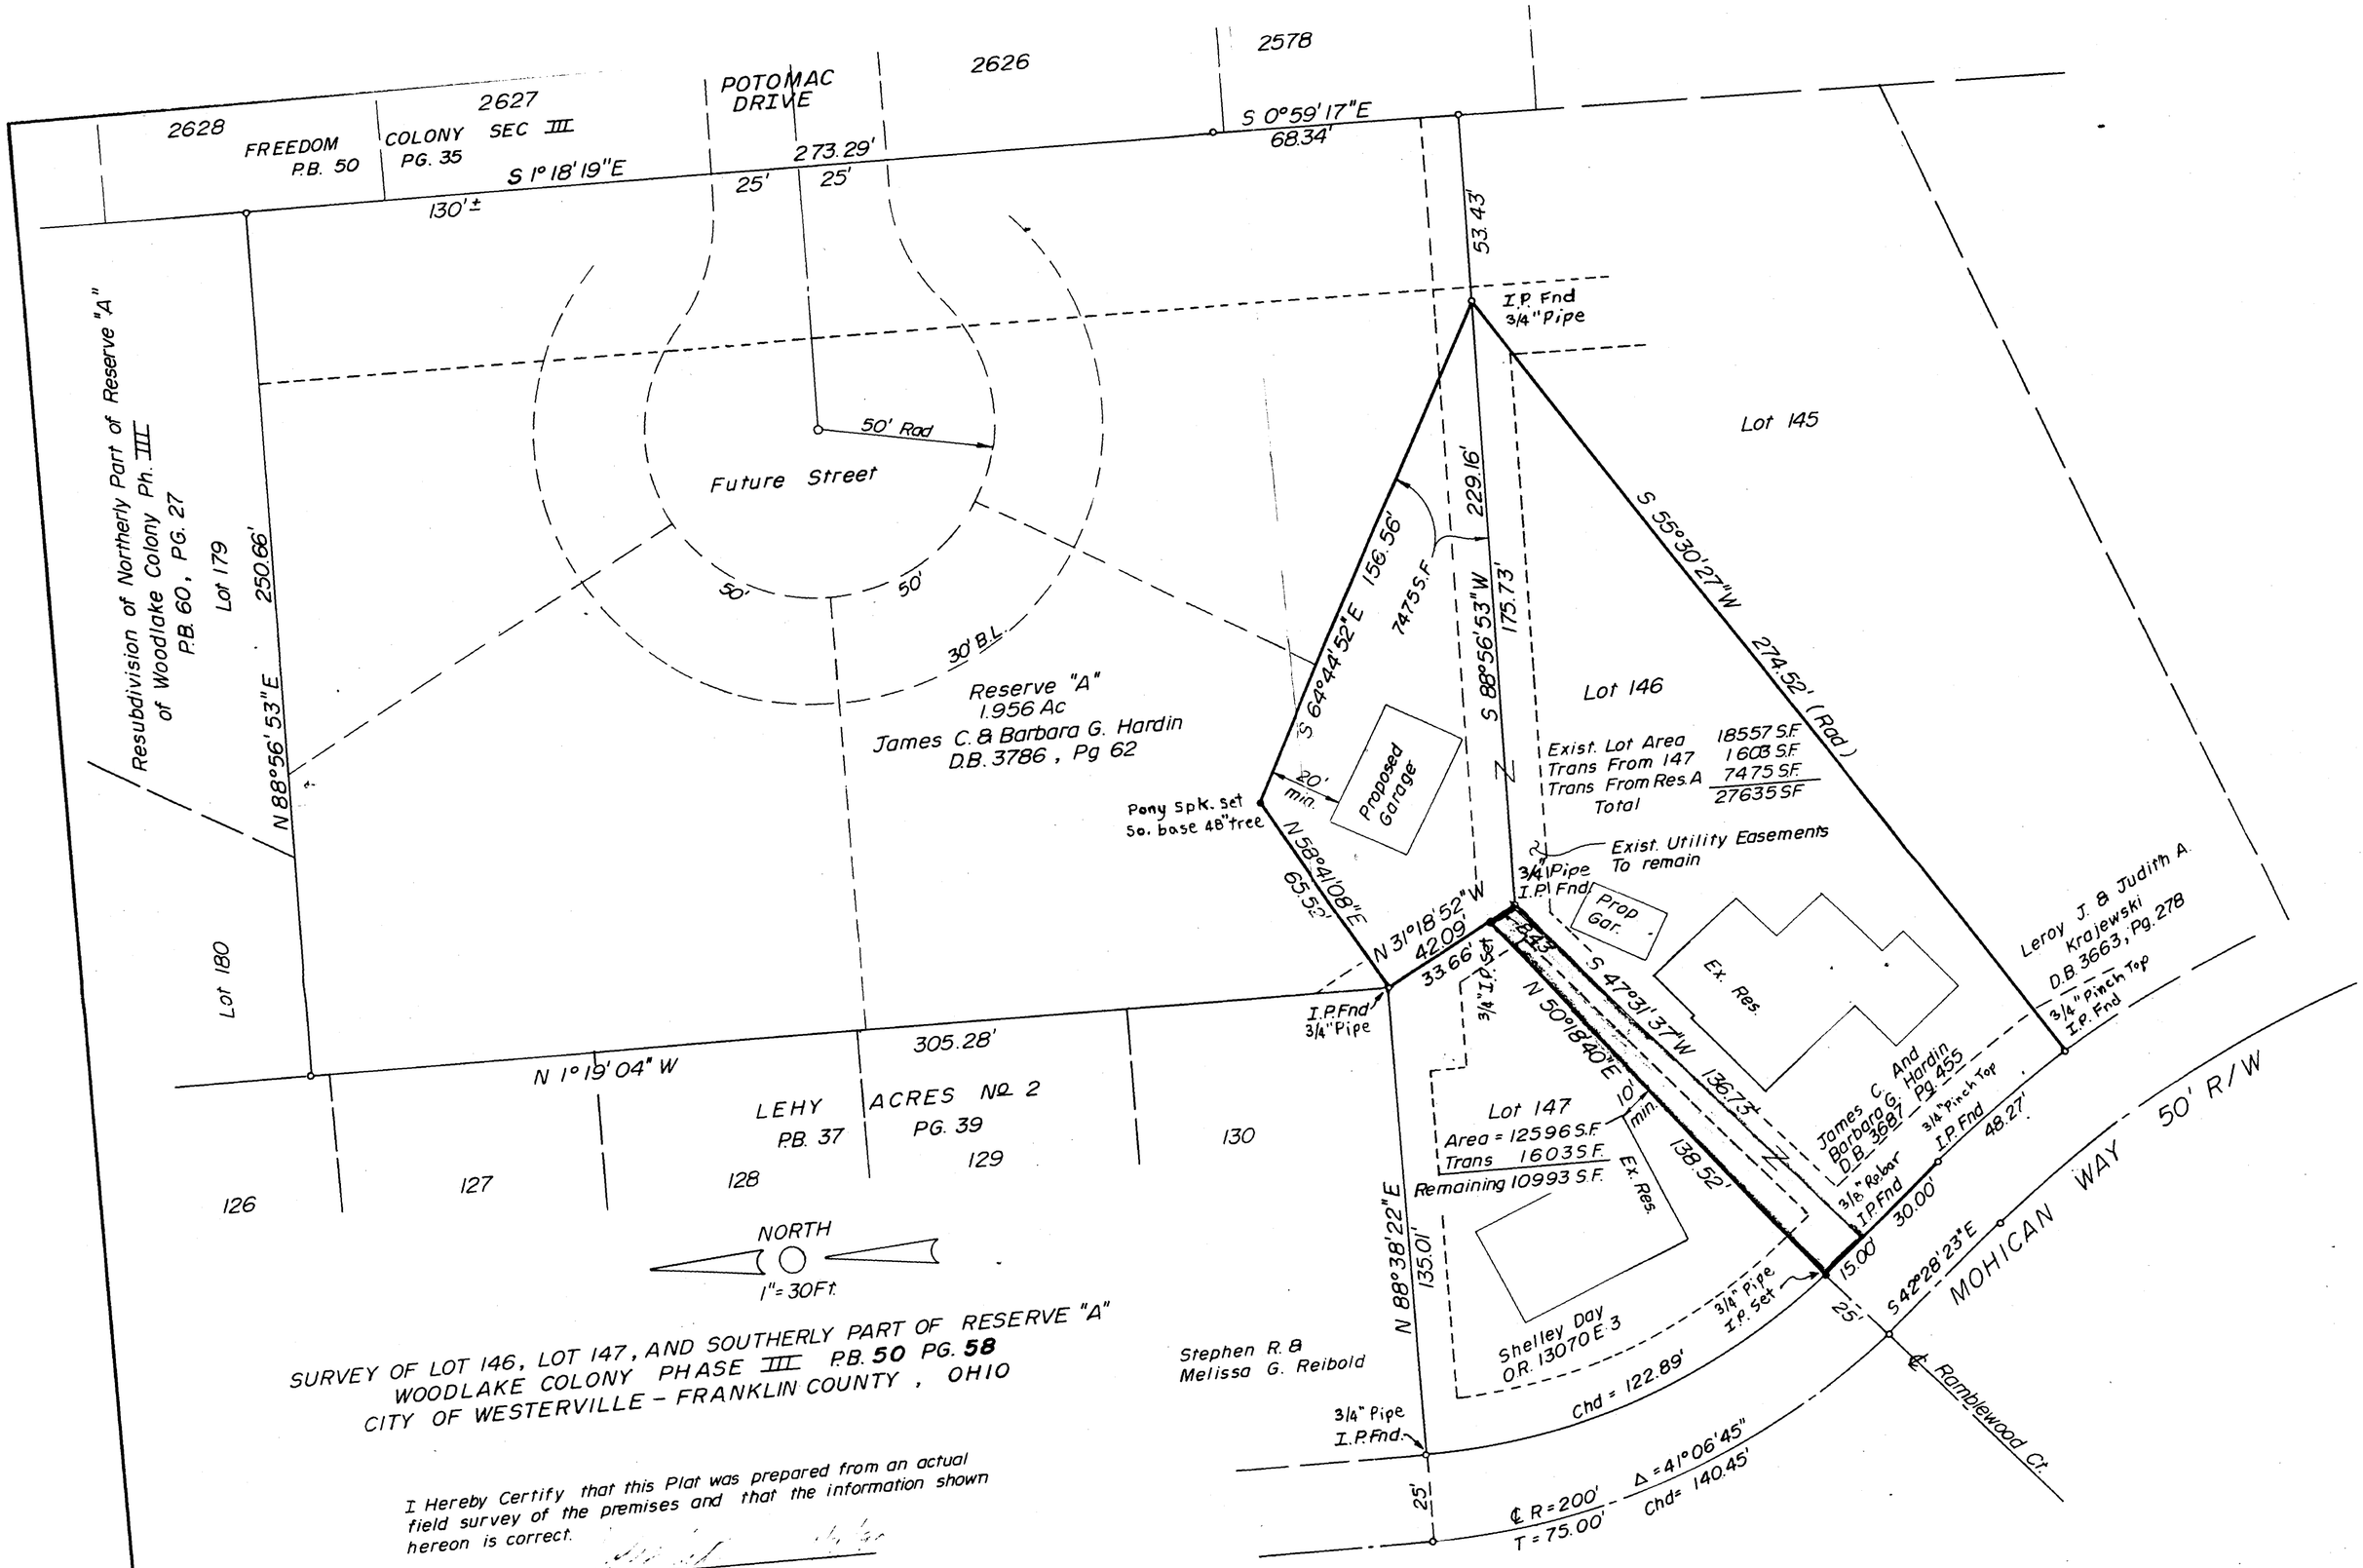

SURVEY OF LOT 146, LOT 147, AND SOUTHERLY PART OF RESERVE "A"
WOODLAKE COLONY PHASE III P.B. 50 PG. 58
CITY OF WESTERVILLE - FRANKLIN COUNTY, OHIO

I Hereby Certify that this Plat was prepared from an actual field survey of the premises and that the information shown hereon is correct.

Ohio Registered Surveyor # 5674

THE BEARING USED HEREON ARE TAKEN FROM BEARINGS RECORDED P.B. 50, PAGE 58

STATE OF OHIO
ROBERT A. HOCK
5674
REGISTERED SURVEYOR

Prepared By: HUGHES ENGINEERING