REFERENCES
Deeds as noted
County tax maps
Previous surveys
Existing monuments

LEGEND
● = point
⊙ = 5/8' iron pin with a plastic identification cap set stamped "Seymour-6044"
○ = 5/8"iron pin found
□ = concrete monument found
○ = 1/2" iron pipe found
○ = 3/4" iron pipe found

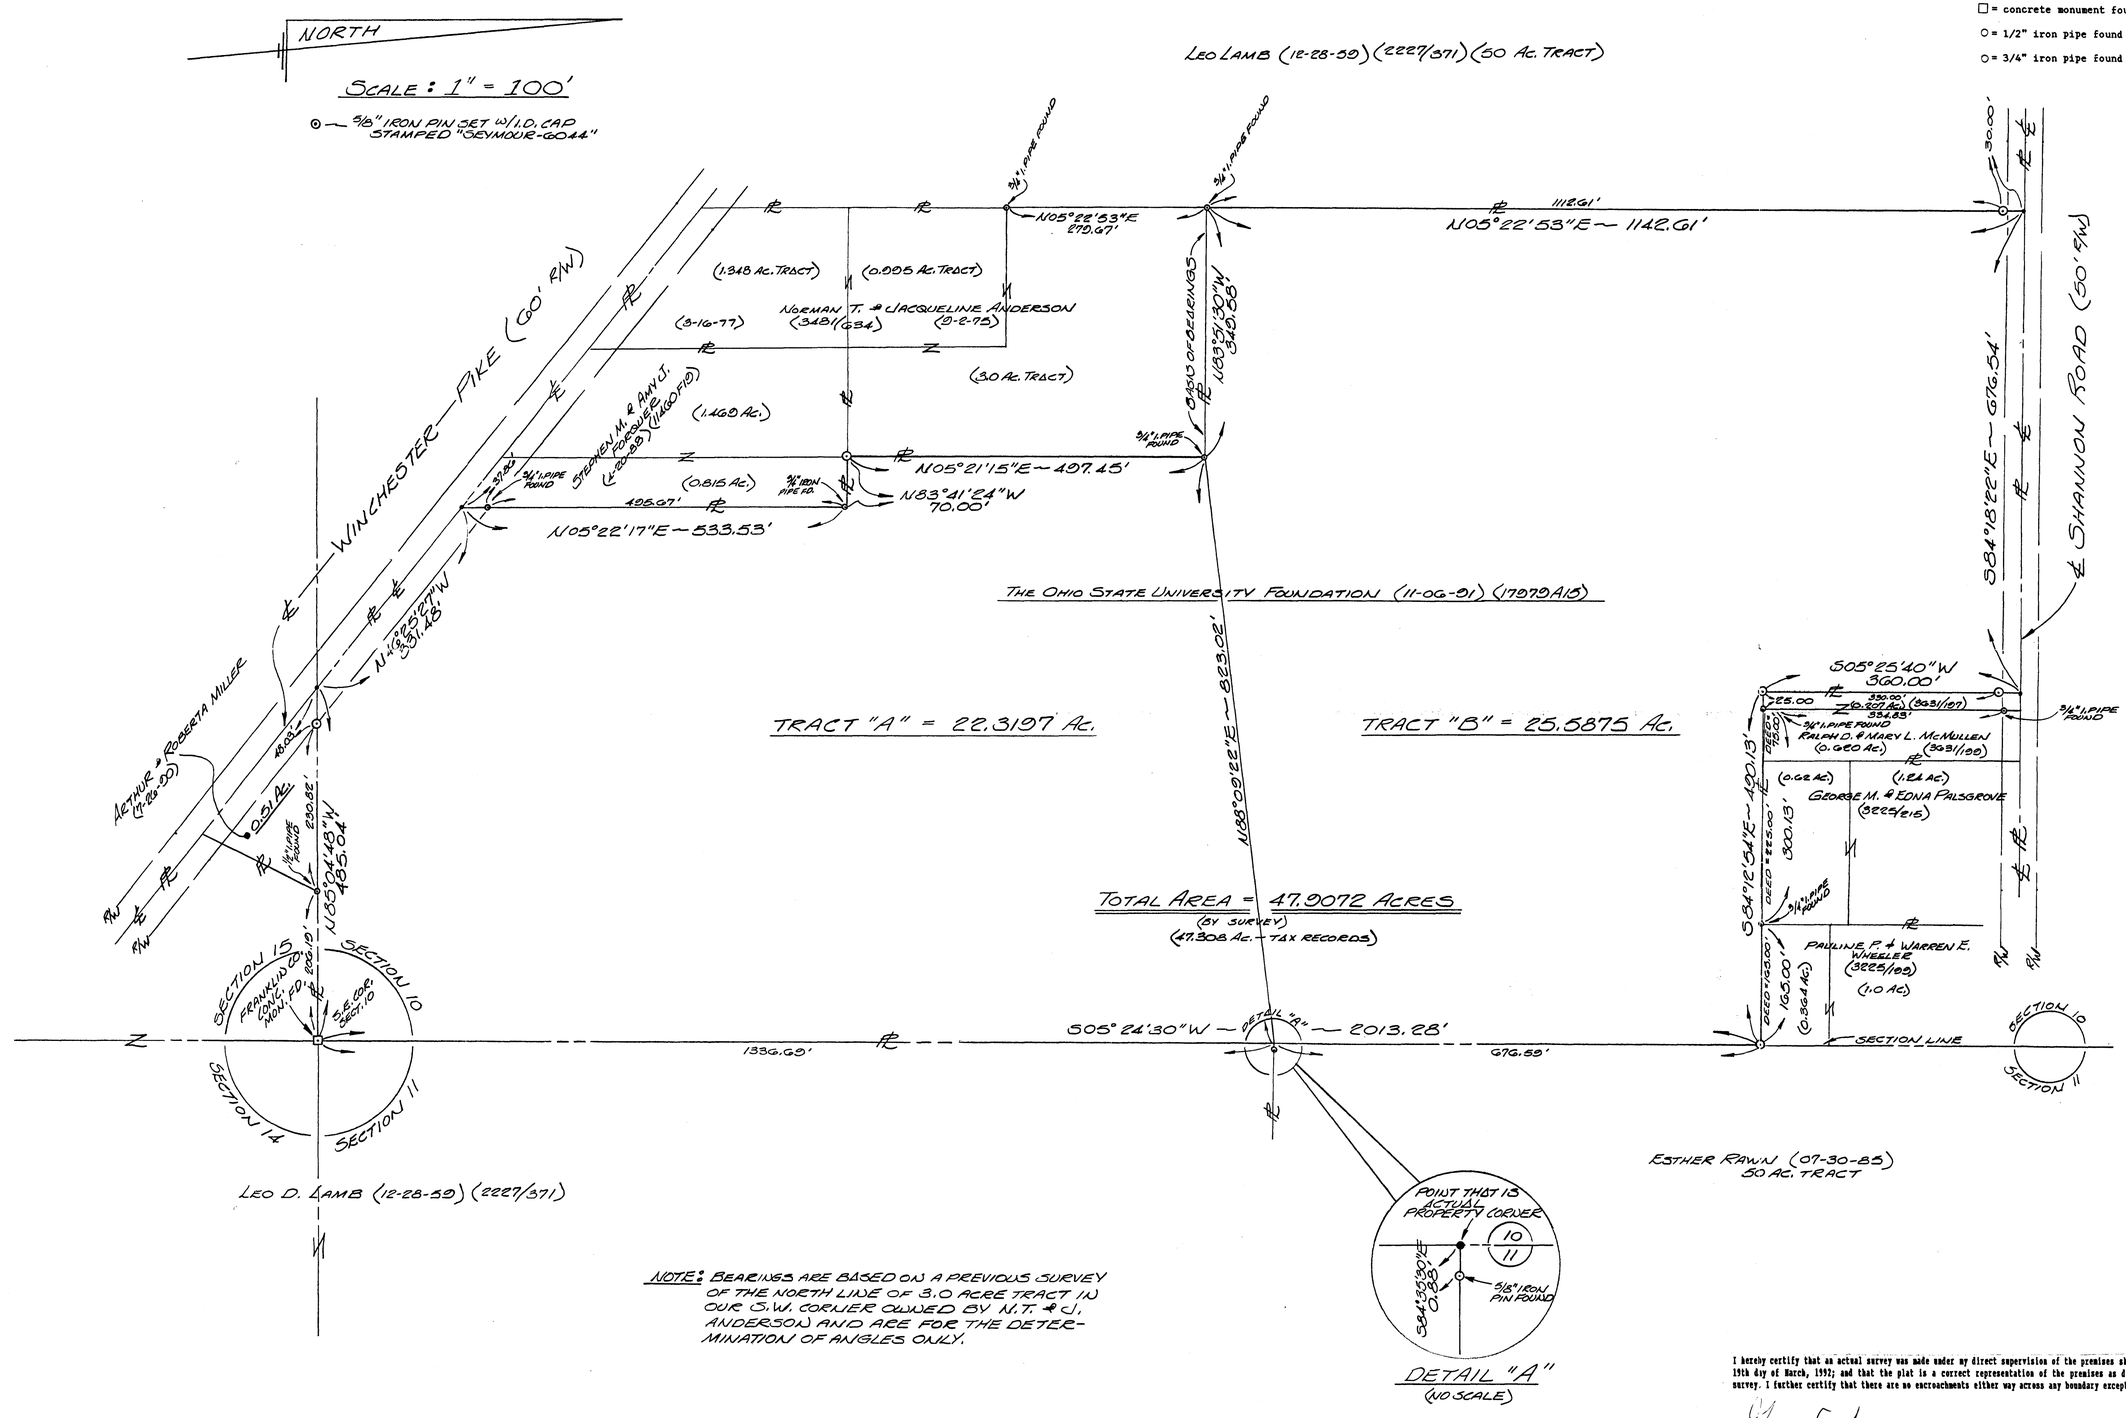

NOTE: BEARINGS ARE BASED ON A PREVIOUS SURVEY OF THE NORTH LINE OF 3.0 ACRE TRACT IN OUR S.W. CORNER OWNED BY N.T. & J. ANDERSON AND ARE FOR THE DETERMINATION OF ANGLES ONLY.

I hereby certify that an actual survey was made under my direct supervision of the premises shown hereon on the 19th day of March, 1992; and that the plat is a correct representation of the premises as determined by said survey. I further certify that there are no encroachments either way across any boundary except as shown hereon.

George F. Seymour
OHIO PROFESSIONAL SURVEYOR NO. 6044

STATE OF OHIO — GEORGE F. SEYMOUR S-6044 — REGISTERED SURVEYOR

seymour & assoc. consultants
(614) - 385 - 4349
69 s. market logan, ohio 43138

SITUATE IN THE S.E. 1/4 OF SECTION 10 ~ T11 ~ R21
MADISON TWP. ~ FRANKLIN CO. ~ OHIO

SURVEYED FOR: CENTRAL OHIO MISSION ASSOCIATION

date	3/19/92
drawn	GS
job	F92001
revisions	
sheet	

9239 C