

# Myers Surveying Company, Inc.

2740 East Main Street, Columbus 43209 (Bexley), Ohio  
 614-235-8677 FAX: 614-235-4559

A Boundary Survey prepared for and certified to:  
**Landsel Title Agency**

**Legal Description:** Situated in Ohio, County of Franklin, City of Columbus, Being Part of Block 7 John McGown's Addition, Deed Book "G" Page 70

**Applicant:** Ferris, Michael

**Posted Address:** 533 S. Third Street, Columbus, Ohio

**F.E.M.A. Flood Zone Designation:** Flood Zone "X" as per F.I.R.M. 390170 0255H




Scale: 1" = 20'

Date: 5 - 18 - '04

Rev: 7-1-2004

City Park Ave. 66'

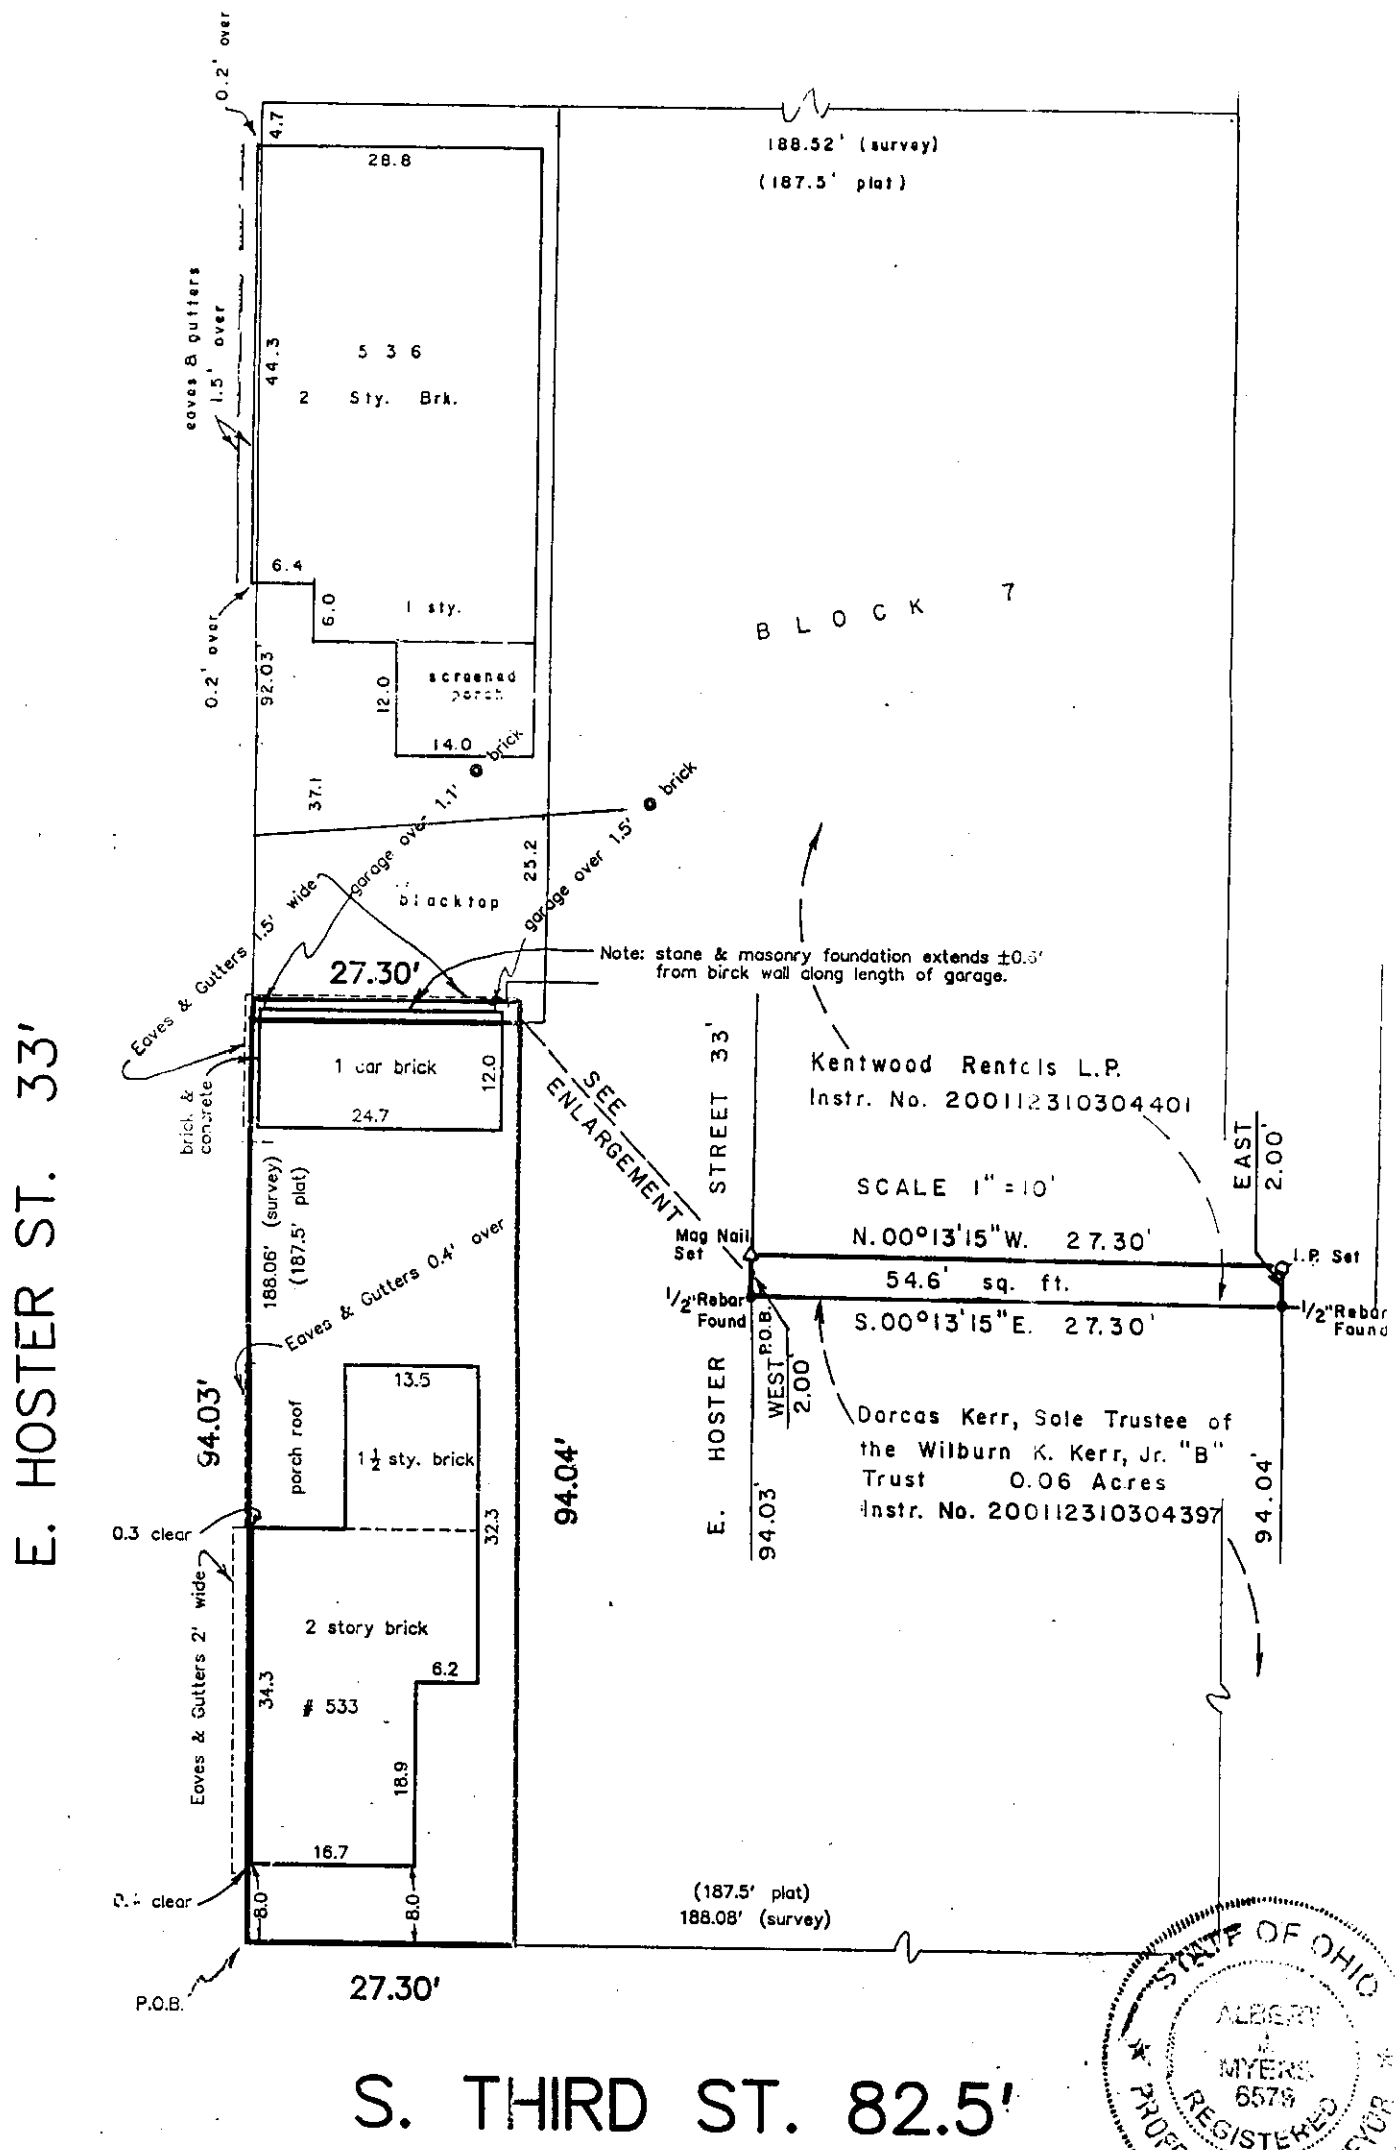

E. HOSTER ST. 33'

S. THIRD ST. 82.5'



By: *Albert Myers*  
 Professional Surveyor

We hereby certify that the foregoing Boundary Survey was prepared from actual field measurements in accordance with Chapter 4733-37 Ohio Administrative Code. Iron pins set are 30"x1" O.D. with an orange plastic plug inscribed "P.S. 6579", unless otherwise noted. Basis of bearings is assumed to be WEST on the North line of East Hoster St.

Myers Order No. - 30-04/28/04 Rec. *BS* Field *BS* *SS* *MS* *CS*