K-14.

Columbus OH

Myers Surveying Company, Inc.

2740 East Main Street, Columbus 43209 (Bexley), Ohio
614-235-8677 FAX: 614-235-4559

A Boundary Survey prepared for and certified to:
RR Associates Inc.

Legal Description: Situated in Ohio, County of Franklin, City of Columbus, Being Lots 114 and 115 Wharton Place Addition, Plat Book 5, Page 42 (Alley adjacent to lots)

Posted Address: 566 Wharton Avenue, Columbus, Ohio

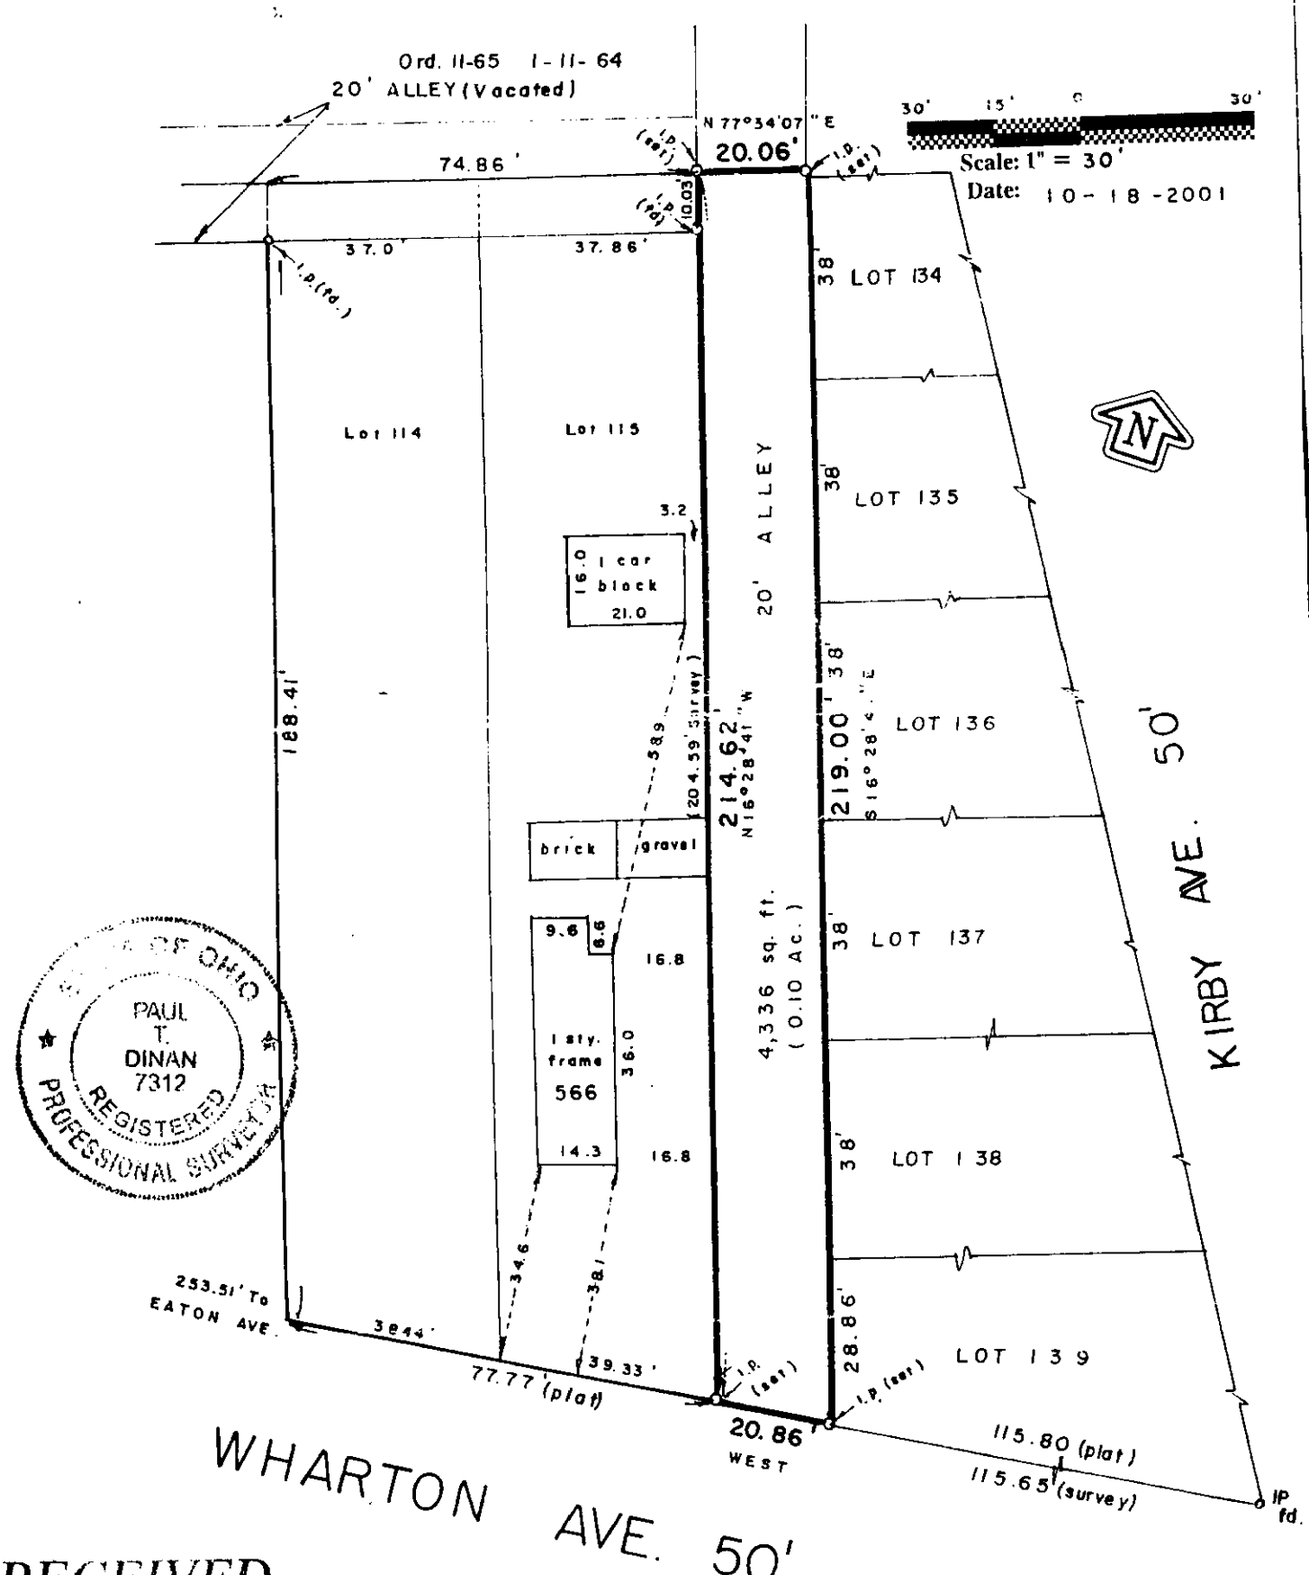

STATE OF OHIO
PAUL T. DINAN 7312
REGISTERED PROFESSIONAL SURVEYOR

RECEIVED
MAY 25 2004

We hereby certify that the foregoing Boundary Survey was prepared from actual field measurements in accordance with Chapter 4733-37 Ohio Administrative Code. Iron pins set are 30"x1" O.D. with an orange plastic plug inscribed "P.S. 6579", unless otherwise noted. Basis of bearing is the centerline of Wharton Avenue as Assumed West

Myers Surveying Co., Inc.
By Paul T. Dinan
Professional Surveyor

Myers Order No. - 6-10/08/01	Rec.	Field	DWG	Ltr.	Ck.

8235-7050