

Myers Surveying Company, Inc.

2740 East Main Street, Columbus 43209 (Bexley), Ohio
 614-235-8677 FAX: 614-235-4559

A Boundary Survey prepared for and certified to:
Jim Stewart

Legal Description: Situated in Ohio, County of Franklin, Township of Franklin, Being 0.568 Acres in Virginia Military Survey #717

Posted Address: 1073 Geneva Avenue




Scale: 1" = 40'

Date: 12-29-03

Lynn Mann
 D.B. 3605, PG. 800

Jack E. Parrett
 O.R.V. 18139, PG. I 10

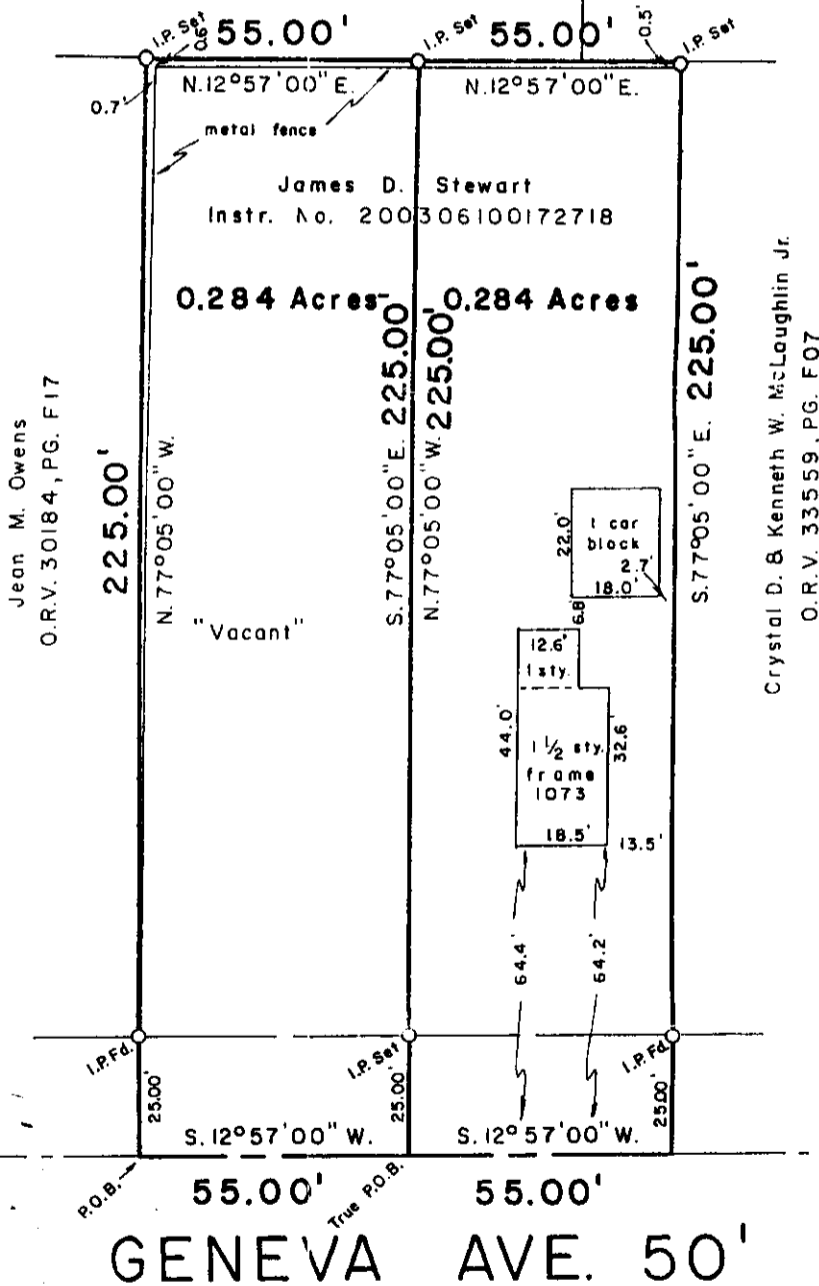


Crystal D. & Kenneth W. McLaughlin Jr.
 O.R.V. 33559, PG. F07

RECEIVED

JAN 29 2004

Franklin County Engineer
 Dean C. Ringle, P.E., P.S.

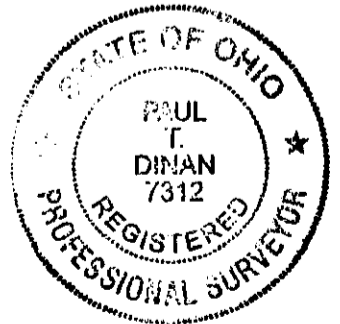

We hereby certify that the foregoing Boundary Survey was prepared from actual field measurements in accordance with Chapter 4733-37 Ohio Administrative Code. Iron pins set are 30"x1" O.D. with an orange plastic plug inscribed "P.S. 0579", unless otherwise noted. Basis of bearing is South 12 degrees 57 minutes 00 seconds West on the centerline of Geneva Avenue per Instr. No. 200306100172718.

Myers Surveying Co., Inc.

By *Paul T. Dinan*
 Professional Surveyor

Myers Order No. - 13-12/16/03 | Rec. | Field *JA/PPD* | DWG *PPD* | Ltr. *PPD* | Ck.

0-22-A
FRANKLIN Twp.

81357050