EMH&T INC.
ENGINEERS, SURVEYORS, PLANNERS, SCIENTISTS
EVANS, MECHWART, HAMBLETON & TILTON, INC.
170 MILL STREET, GAHANNA, OHIO 43230
TELEPHONE (614) 471-5150 - FACSIMILE (614) 471-9286

SURVEY OF ACREAGE PARCEL

QUARTER TOWNSHIP 2, TOWNSHIP 1, RANGE 17
UNITED STATES MILITARY LANDS
CITY OF COLUMBUS, FRANKLIN COUNTY, OHIO

Date: July 6, 2004

Scale: 1" = 100'

Job No: 2003-0327

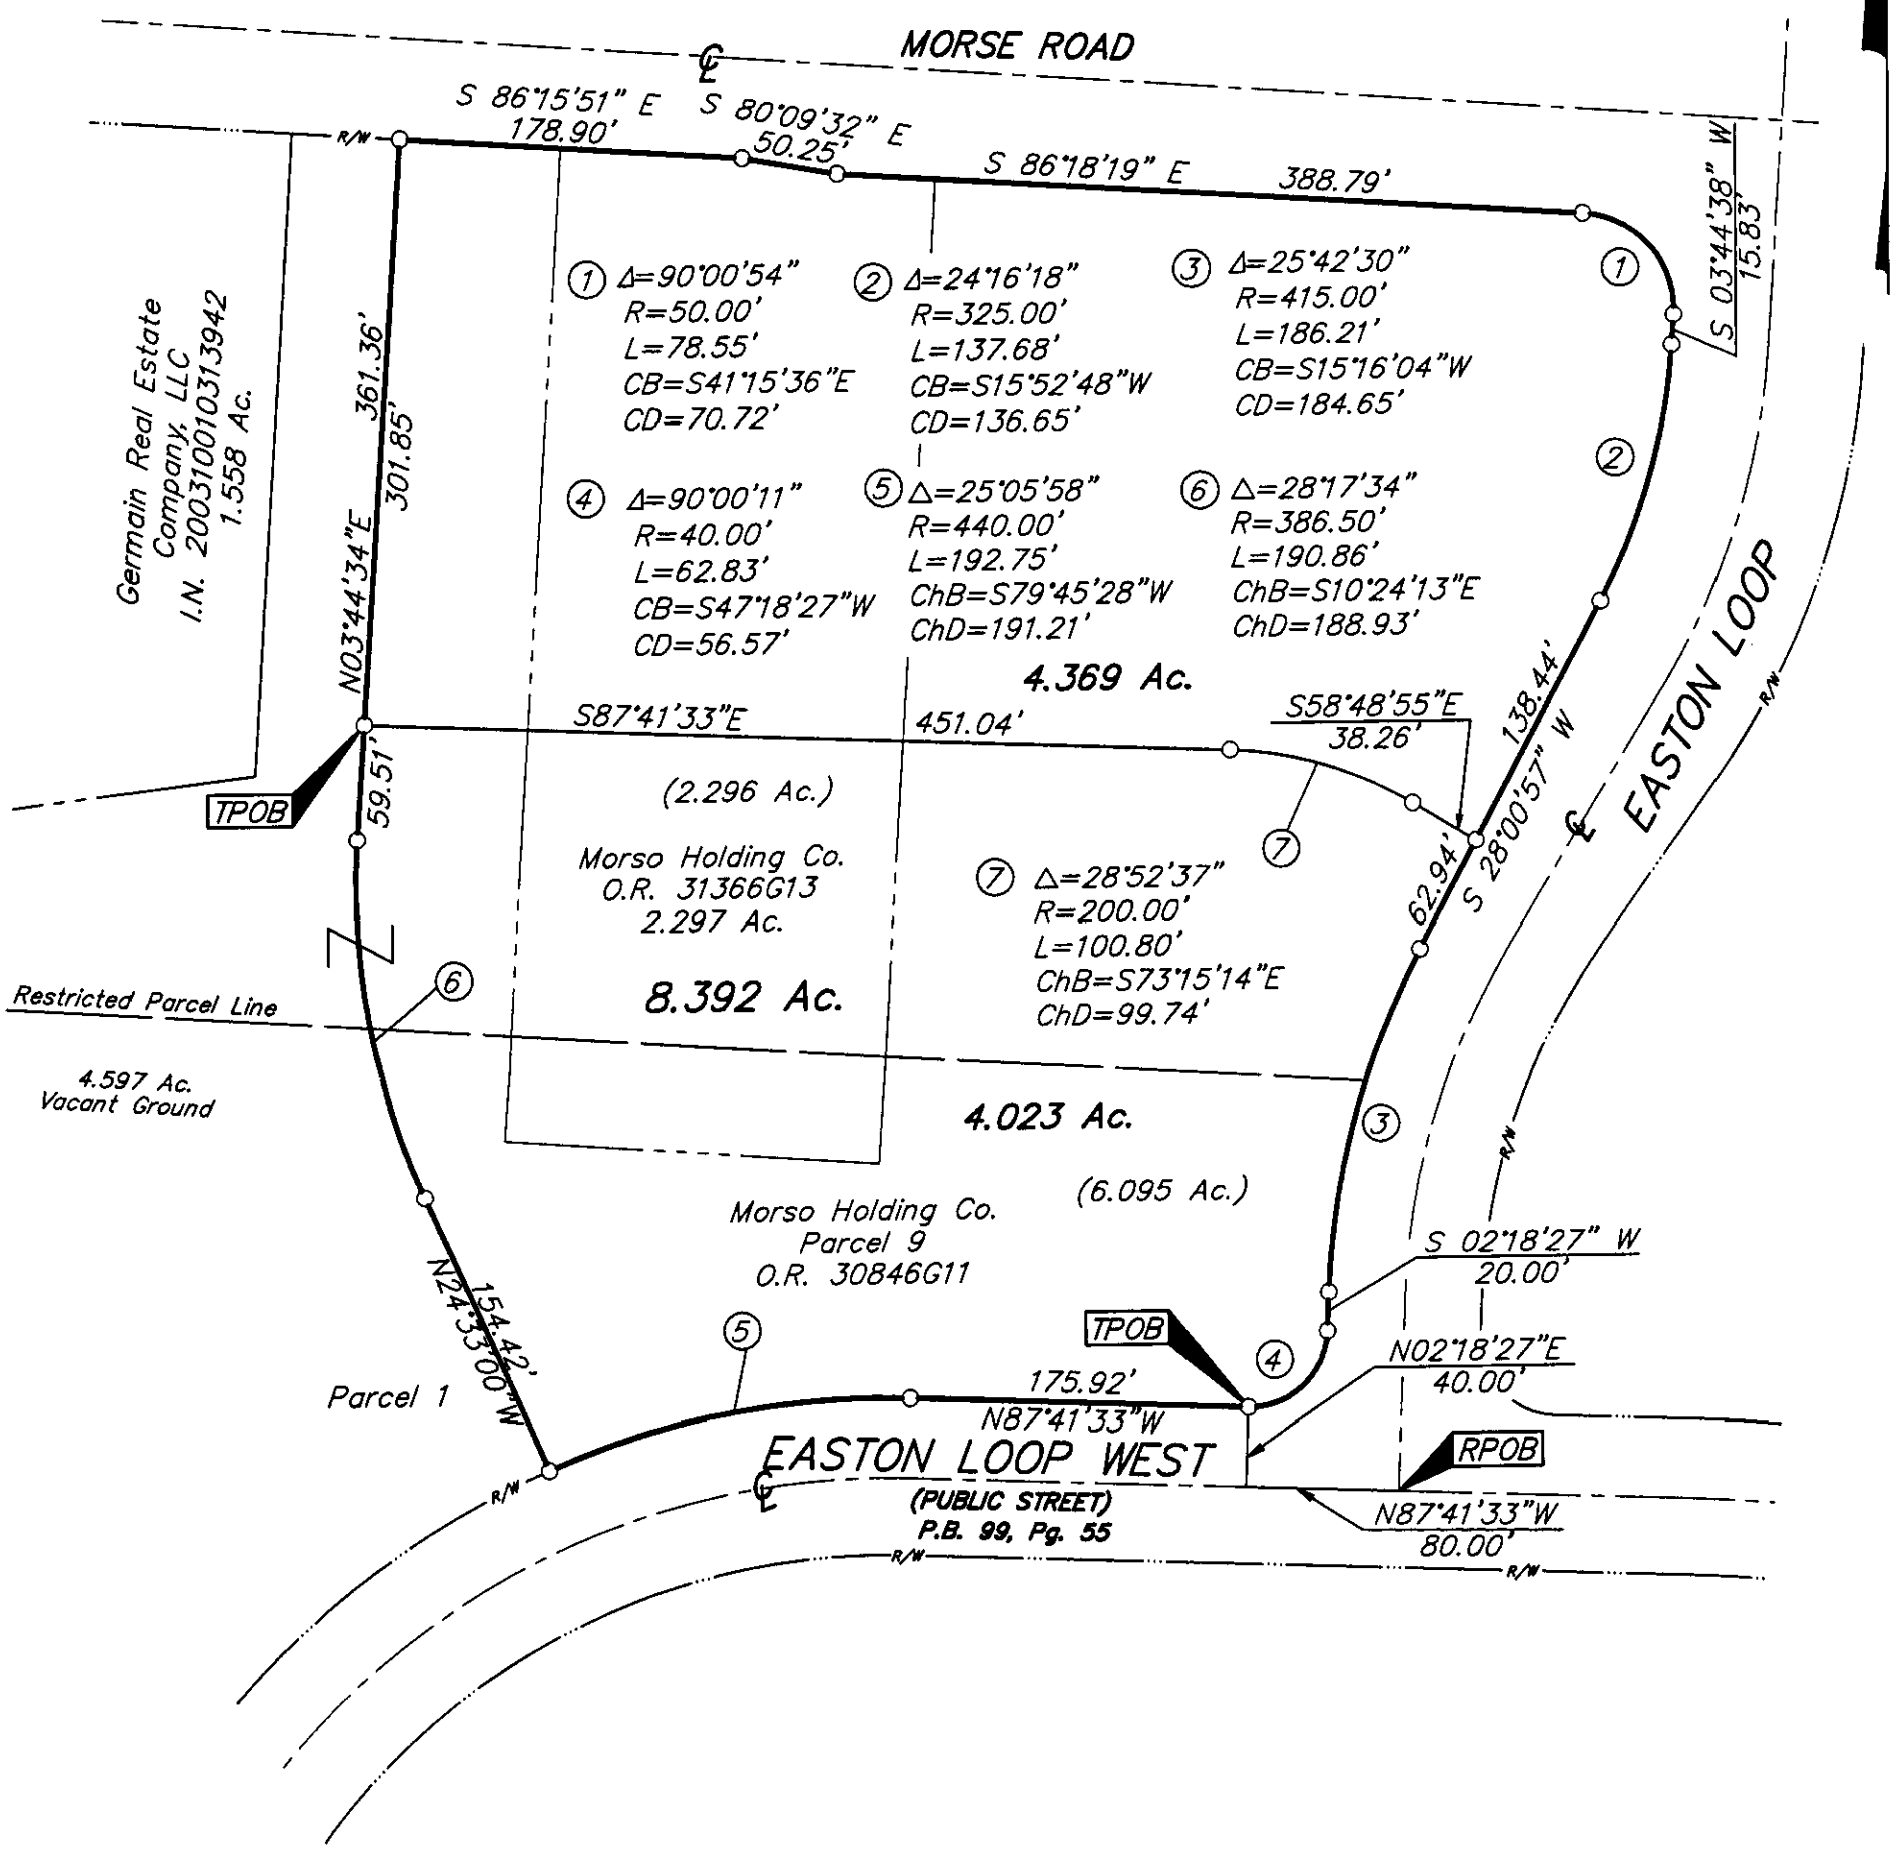

● = STONE FND.
■ = MON. FND.
● = I.P. FND.
○ = I.P. SET
⬢ = MAG. NAIL FND.
⬡ = MAG. NAIL SET
▲ = R.R. SPK. FND.
△ = R.R. SPK. SET
⬟ = P.K. NAIL FND.

I.P. Set are 13/16" I.D. iron pipe with cap inscribed EMHT INC

100' 0 100' 200'

GRAPHIC SCALE (IN FEET)

BASIS OF BEARINGS: Bearings are based on field traverse originating from and tying to Franklin County Control Monuments, including Frank 64 and Frank 164 and determines the bearing for the centerline of Morse Road as South 86° 15' 51" East.

RECEIVED
JUL 15 2004
Franklin County Engineer
Deputy Ring

STATE OF OHIO
JAMES M. PEARSALL
7840
REGISTERED PROFESSIONAL SURVEYOR

By James M Pearsall 7/15/04
Professional Surveyor No. 7840

I:\CAMDATA\SURVEY\PROJECT\20030327\DWG\30327BV5.DWG<11X17 PORTRAIT HP5000> - NO KREES - PLOTTED BY: KWEBER - TUESDAY, JUL 6 2004 - 8:38:19 AM