EMH·T INC.
ENGINEERS, SURVEYORS, PLANNERS, SCIENTISTS
EVANS, MECHWART, HAMBLETON & TILTON, INC.
170 MILL STREET, GAHANNA, OHIO 43230
TELEPHONE (614) 471-5150 - FACSIMILE (614) 471-9286

SURVEY OF ACREAGE PARCEL
SECTION 10, TOWNSHIP 11, RANGE 12
CONGRESS LANDS
CITY OF COLUMBUS, FRANKLIN COUNTY, OHIO

Date: March 1, 2004
Scale: 1" = 100'
Job No: 2004-0367

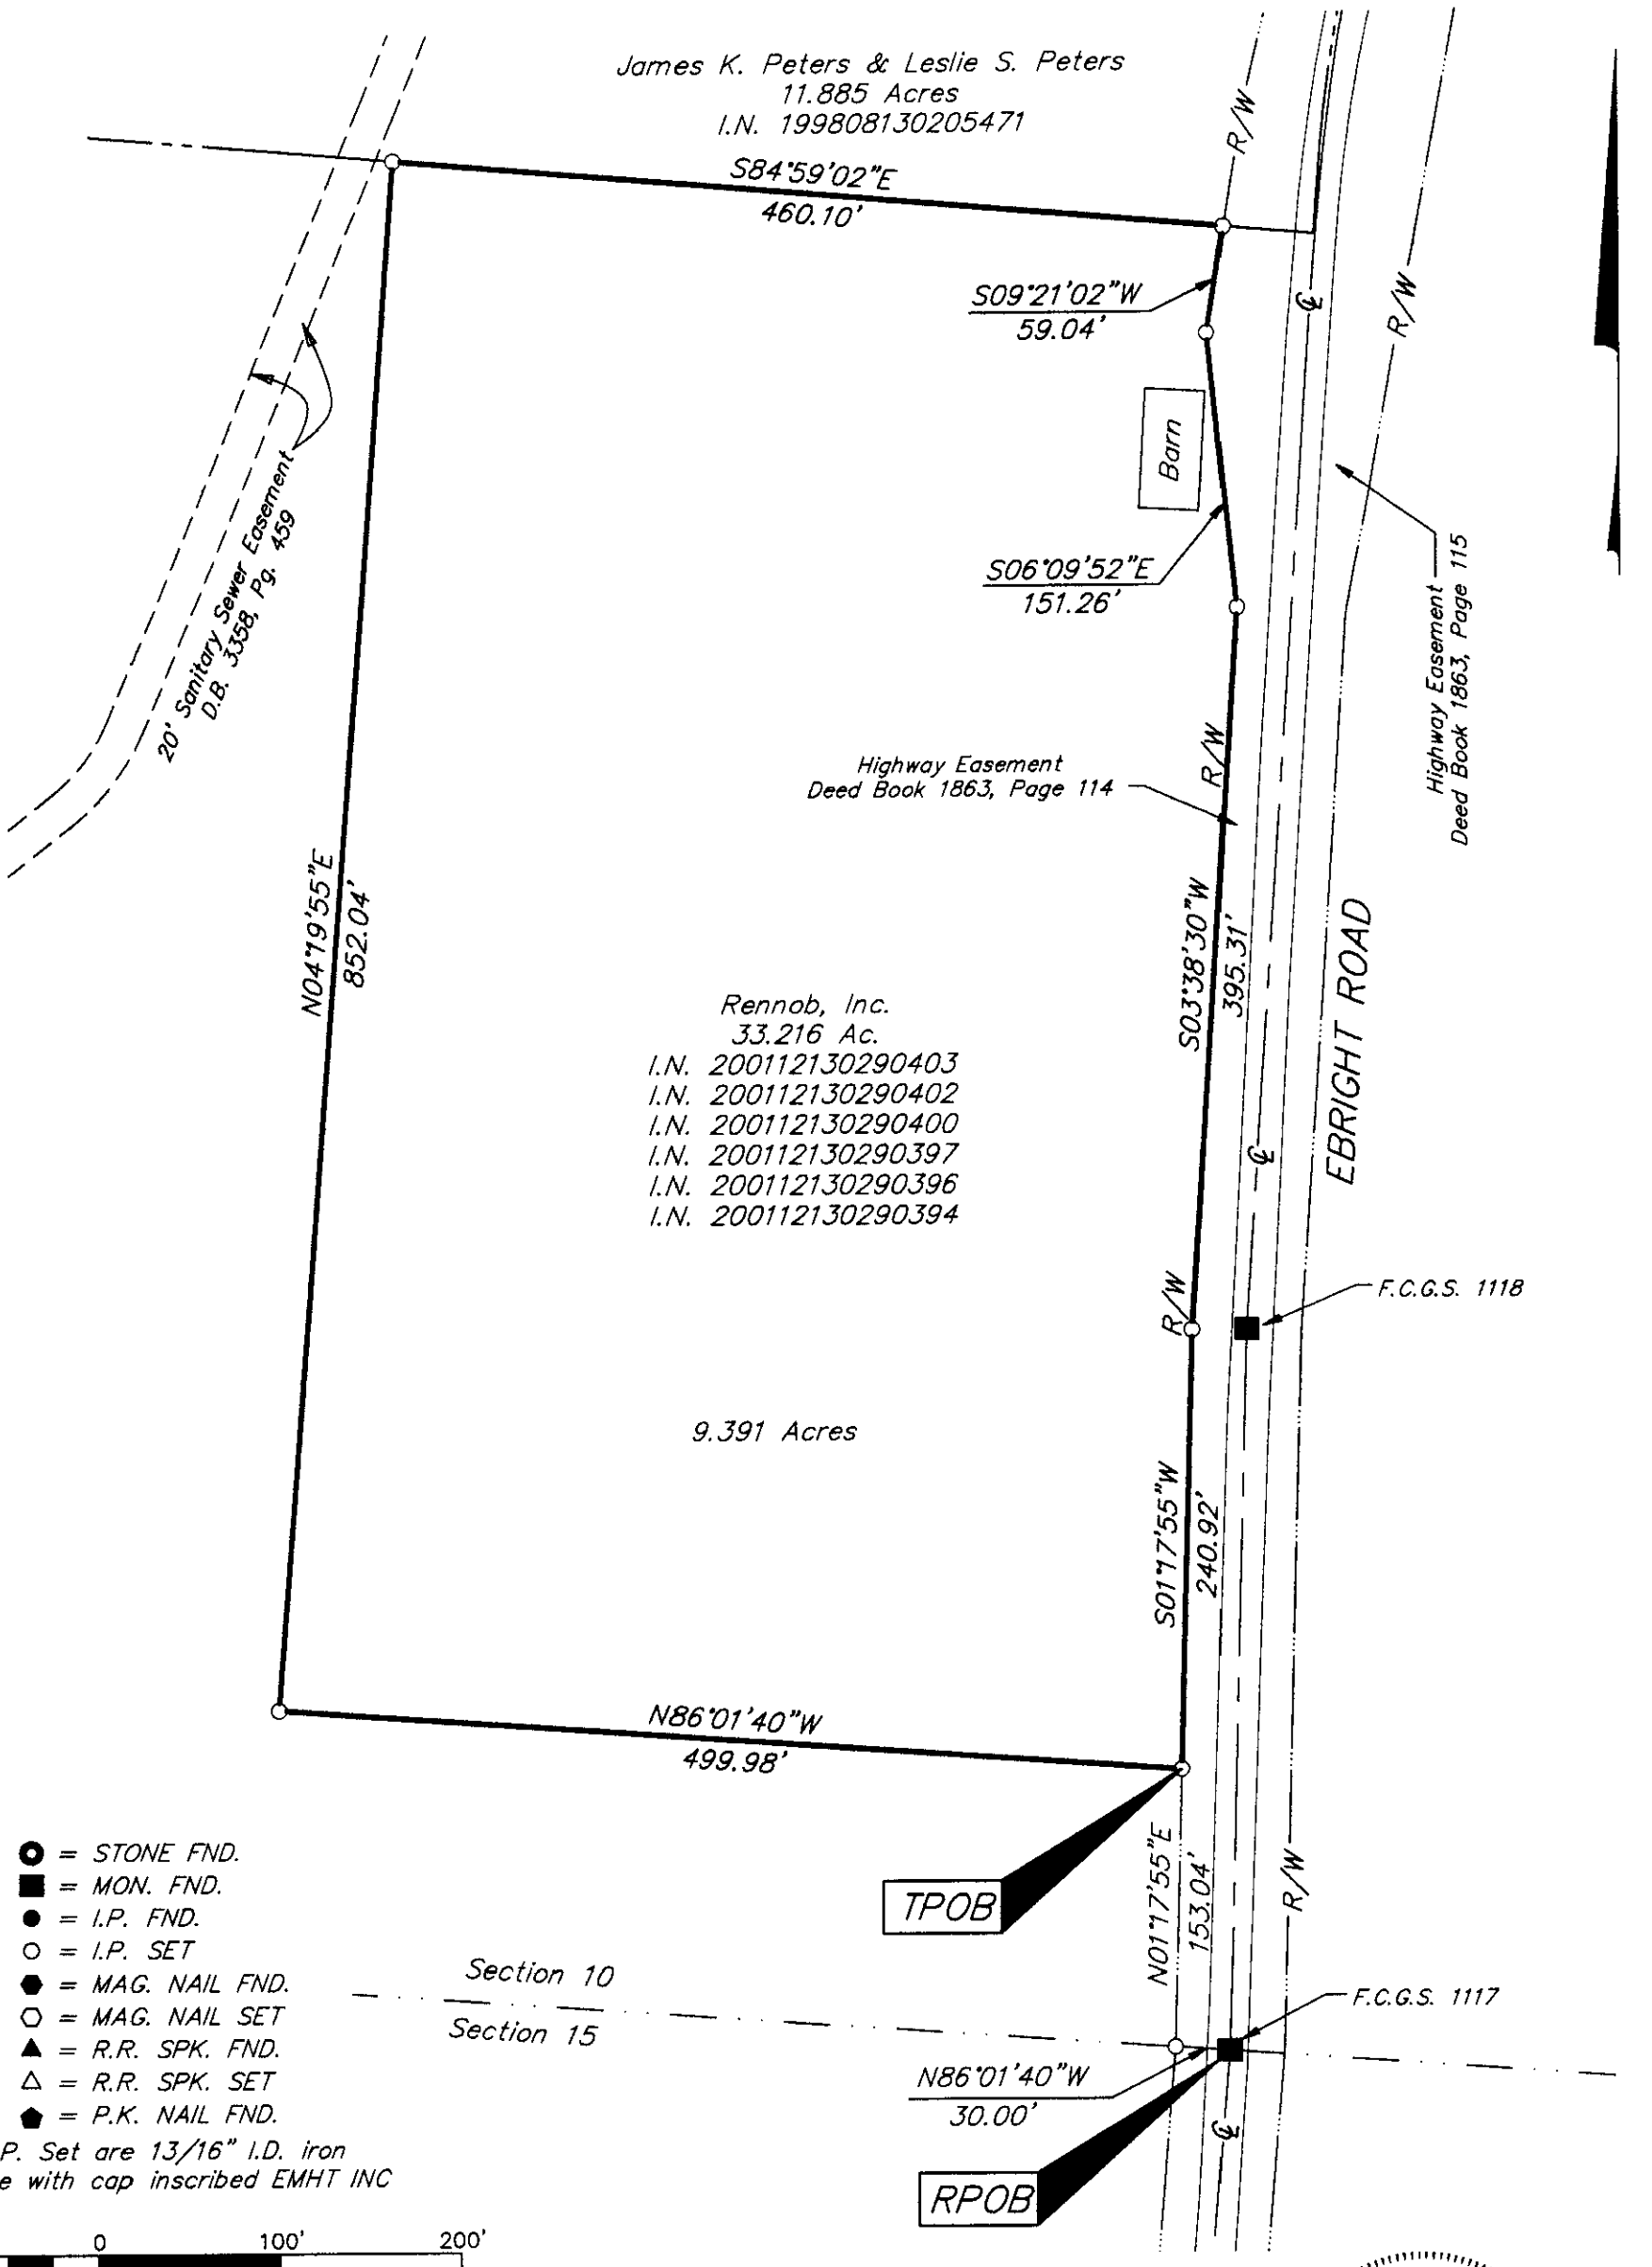

= STONE FND.
= MON. FND.
= I.P. FND.
= I.P. SET
= MAG. NAIL FND.
= MAG. NAIL SET
= R.R. SPK. FND.
= R.R. SPK. SET
= P.K. NAIL FND.

I.P. Set are 13/16" I.D. iron pipe with cap inscribed EMHT INC

100' 0 100' 200'

GRAPHIC SCALE
(IN FEET)

STATE OF OHIO
JAMES M. PEARSALL
7840
REGISTERED PROFESSIONAL SURVEYOR

BASIS OF BEARINGS: Bearings are based on the Ohio State Plane Coordinate System as per NAD83. Control for bearings was from coordinates of monuments FRANK 32 & 132, having a bearing of South 57°12'05" East, established by the Franklin County Engineering Department, using Global Positioning System procedures and equipment.

By James M. Pearsall 9/24/07
Professional Surveyor No. 7840

\\CMHDATA1\SURVEY\PROJECT\20040367\DWG\40367BV.DWG<11X17 PORTRAIT HP5000> - 0 XREFS. - PLOTTED BY BSMITH - March 01, 2004 - 1:49 PM