

0-77-E
PLEASANT TWP.

Myers Surveying Company, Inc.


2740 East Main Street, Columbus 43209 (Bexley), Ohio
614-235-8677 FAX: 614-235-4559

A Boundary Survey prepared for and certified to:

Laurie Moore Hamilton


Legal Description: Situated in Ohio, County of Franklin, Township of Pleasant, Being 3.001 Acres, Part of Virginia Military Survey Nos. 3481, 7541, 7637 and 8580

Posted Address: 9036 Alkire Road 122.557 Ac., G.L. & J. Farms Ltd.
Instr. No. 200004050066093

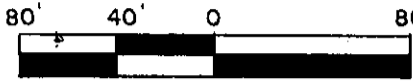

SCALE 1" = 80'

March 18, 2003

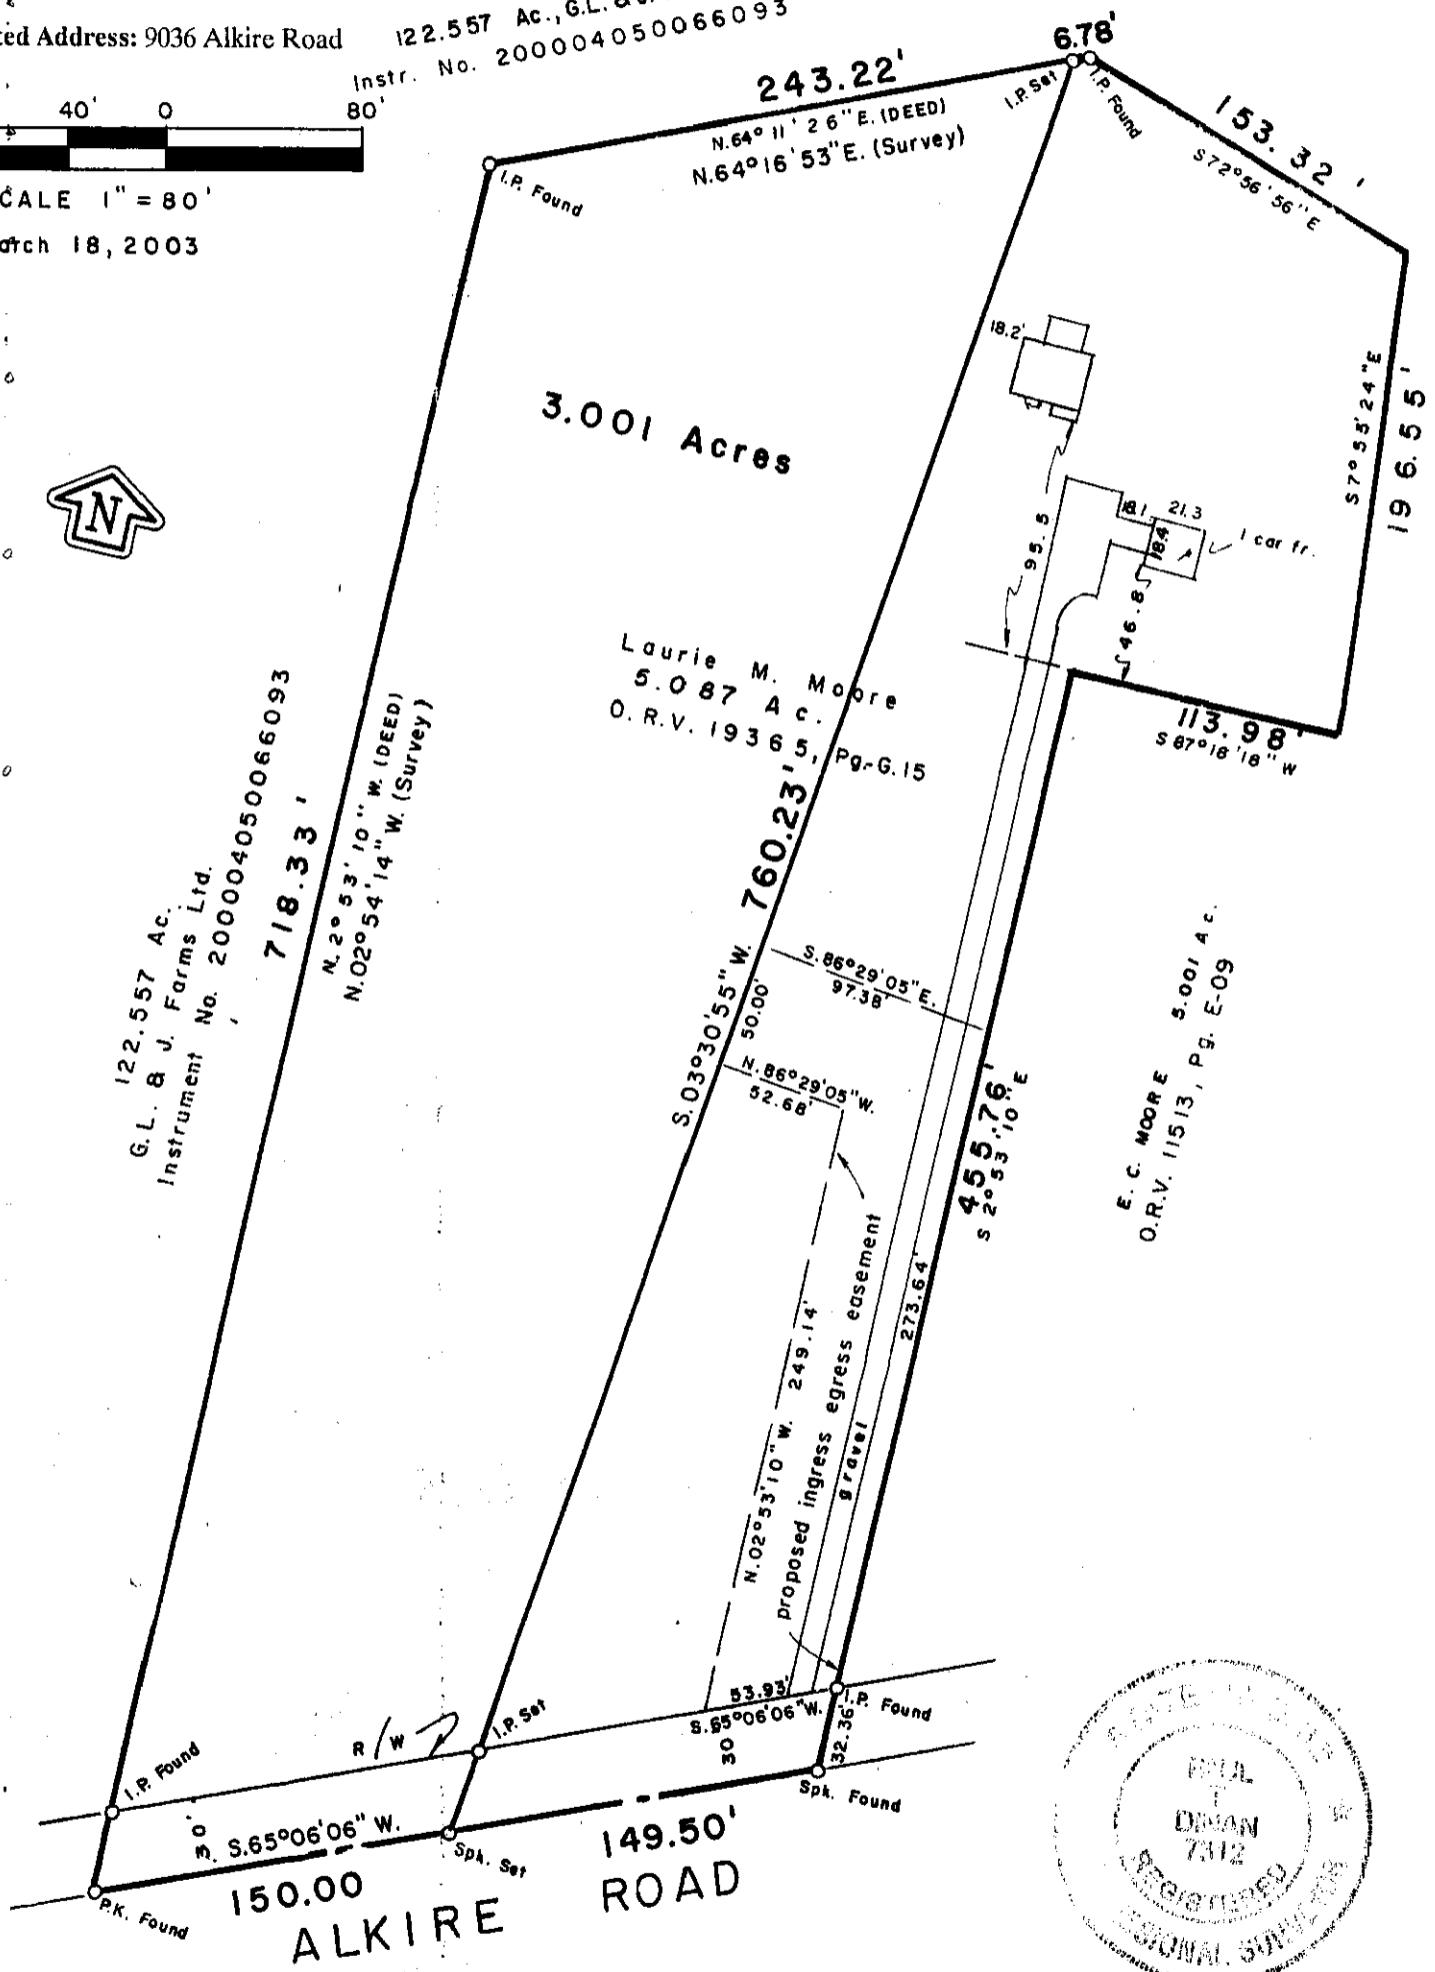

We hereby certify that the foregoing Boundary Survey was prepared from actual field measurements in accordance with Chapter 4733-37 Ohio Administrative Code. Iron pins set are 30"x1" O.D. with an orange plastic plug inscribed "P.S. 6579", unless otherwise noted. Basis of bearing is South 65 degrees 06 minutes 06 seconds West on the centerline of Alkire Road per ORV 19365, Page G15

Myers Surveying Co., Inc.
By Paul T. Simon
Professional Surveyor

76106900