




EVANS, MECHWART, HAMBLETON & TILTON, INC.
170 MILL STREET, GAHANNA, OHIO 43230
TELEPHONE (614) 471-5150 - FACSIMILE (614) 471-9286

SURVEY OF ACREAGE PARCEL
SECTION 5, TOWNSHIP 5, RANGE 22
REFUGEE TRACT
CITY OF COLUMBUS, FRANKLIN COUNTY, OHIO

Date: June 23, 2004


Scale: 1" = 20'

Job No: 2004-1122

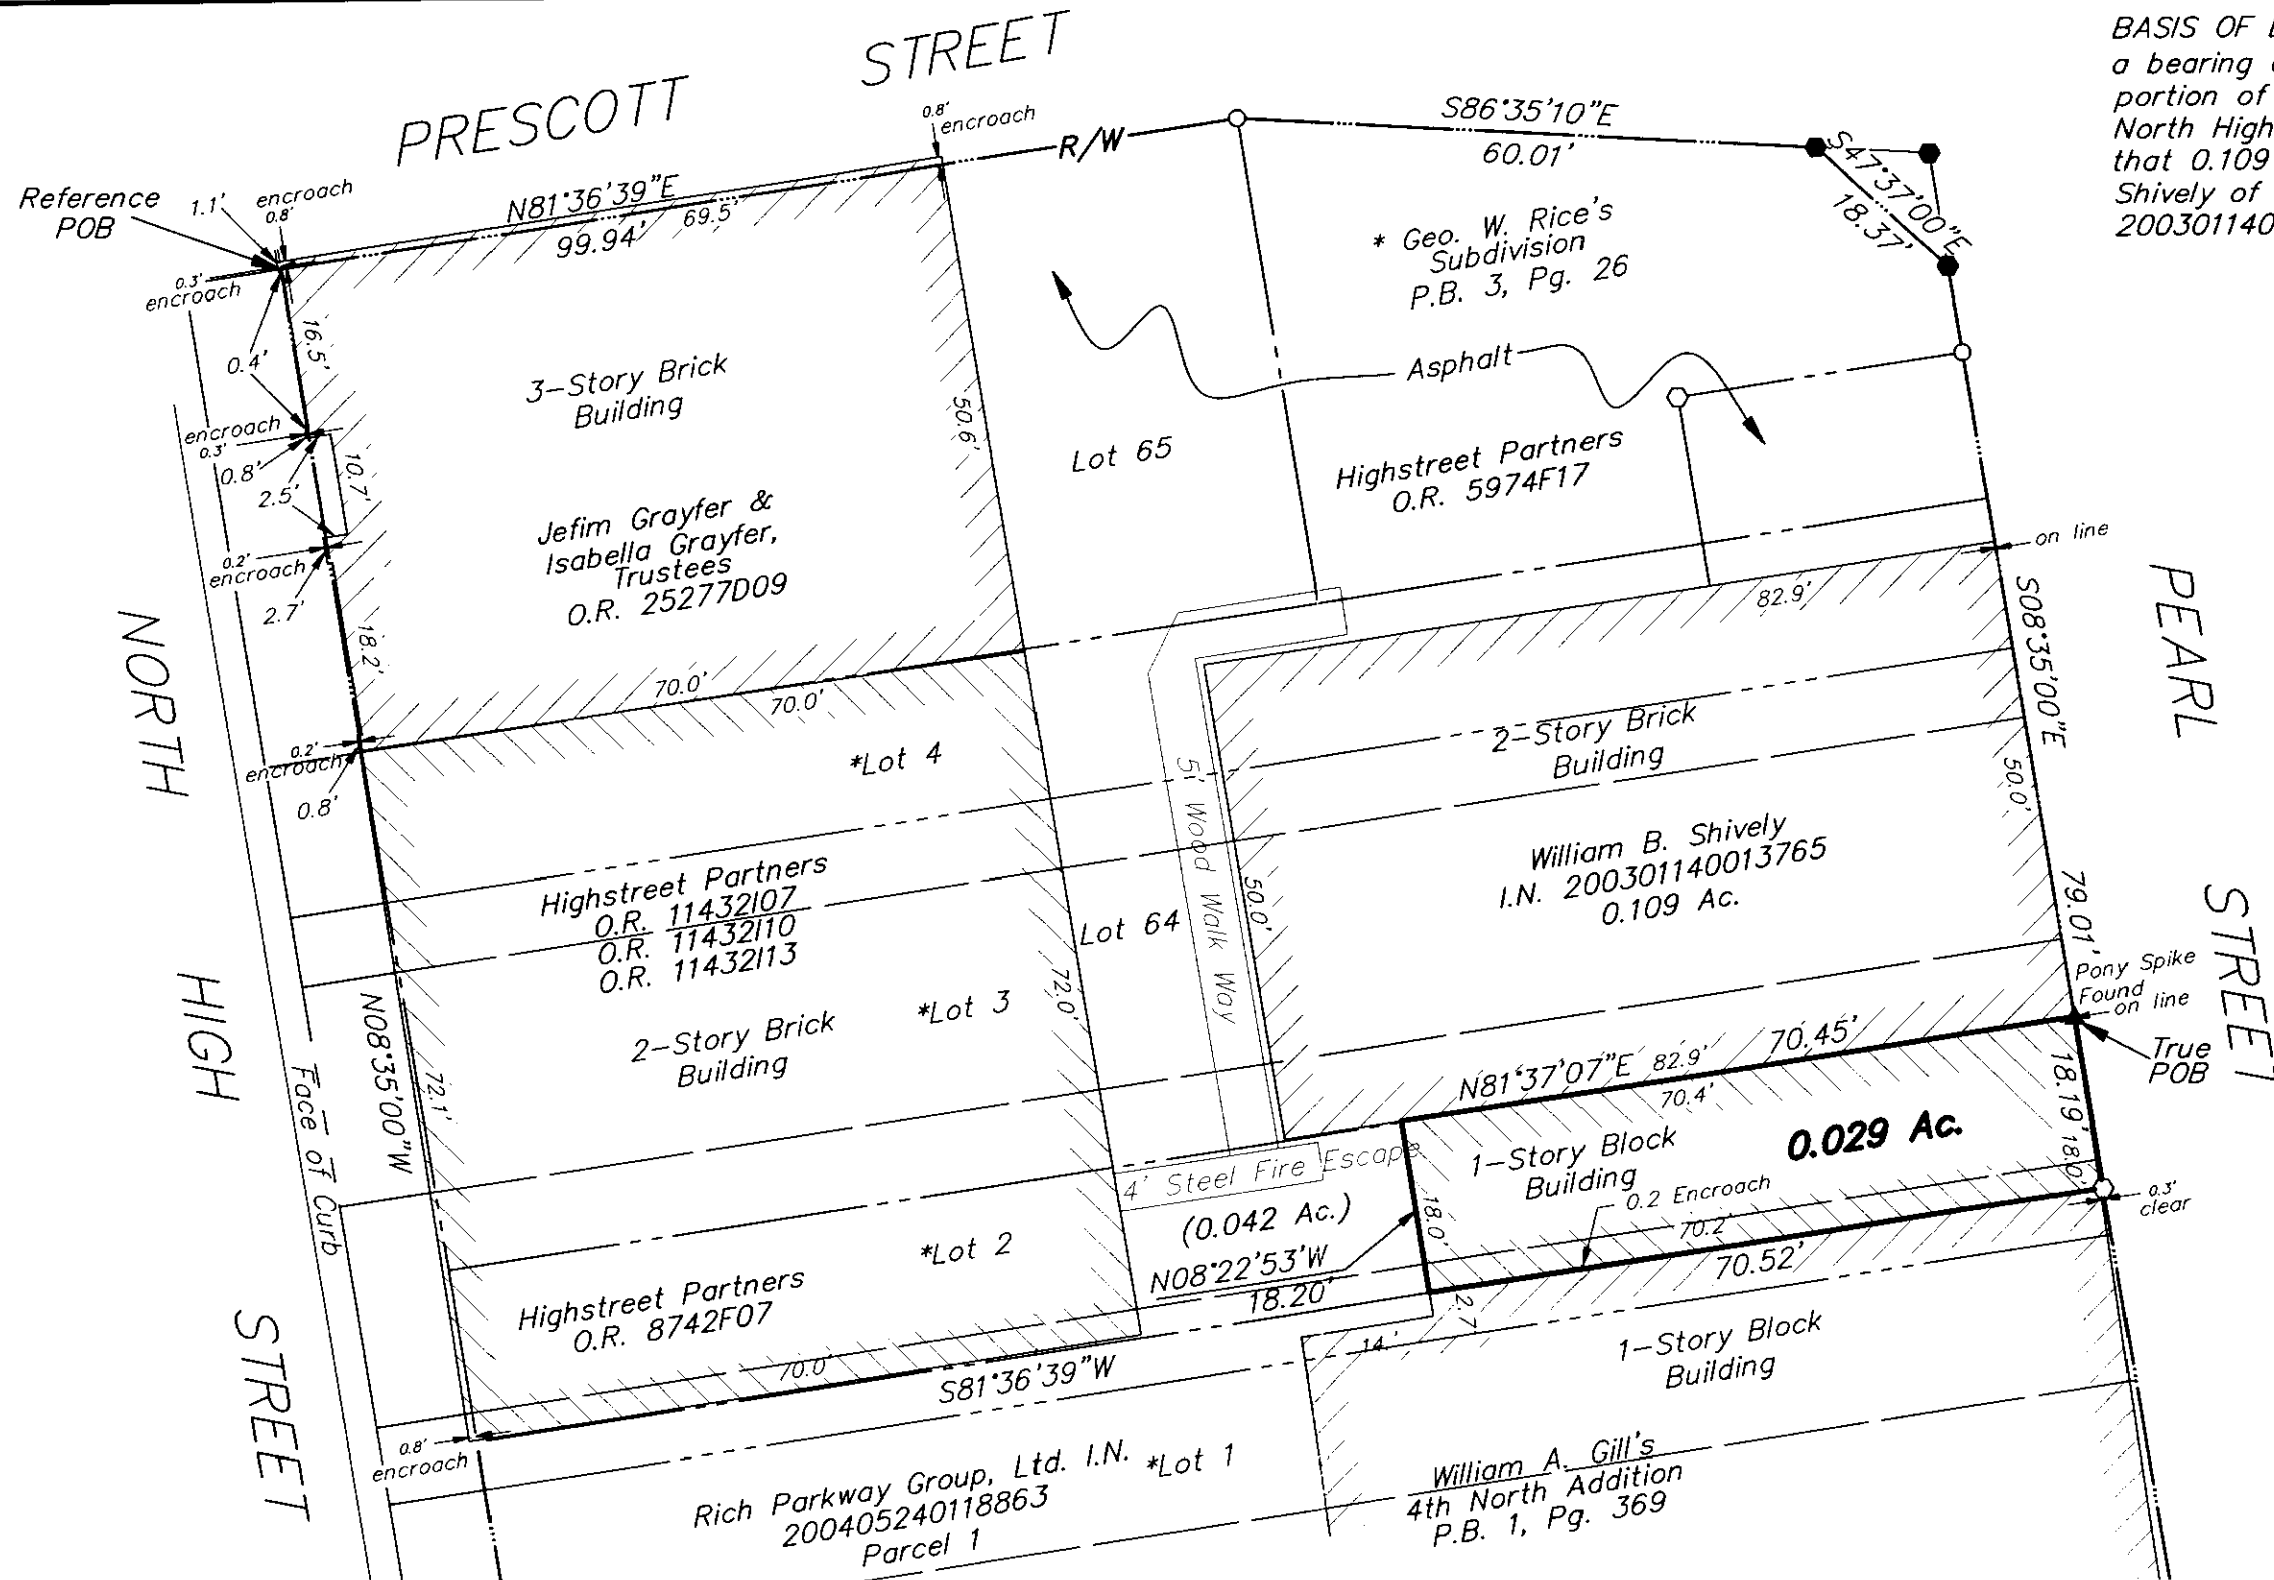

BASIS OF BEARINGS: Bearings are based on a bearing of North 08° 35' 00" West for a portion of the easterly right-of-way line of North High Street from the description of that 0.109 acre tract conveyed to William B. Shively of record in Instrument Number 200301140013765.

RECEIVED
JUN 29 2004
Franklin County Engineer
Dean C. Ringle, P.E., P.S.

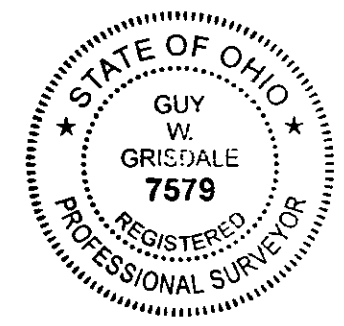

- = STONE FND.
- = MON. FND.
- = I.P. FND.
- = I.P. SET
- = MAG. NAIL FND.
- = MAG. NAIL SET
- ▲ = R.R. SPK. FND.
- △ = R.R. SPK. SET
- = P.K. NAIL FND.

I.P. Set are 13/16" I.D. iron pipe with cap inscribed EMHT INC

By *Guy W. Grisdale*
Professional Surveyor No. 7579

I:\CHM\DATA\1\SURVEY\PROJECT\2004\1122\DWG\1\41122BV_0.029.DWG-11X17.LAND_HF5000- NO XREFS - PLOTTED BY: CMCKEE - FRIDAY, JUN 25 2004 - 4:11:51 PM