




EVANS, MECHWART, HAMBLETON & TILTON, INC.
170 MILL STREET, GAHANNA, OHIO 43230
TELEPHONE (614) 471-5150 - FACSIMILE (614) 471-9286

RIGHT-OF-WAY TAKE
QUARTER TOWNSHIP 3, TOWNSHIP 1, RANGE 17
UNITED STATES MILITARY LANDS
CITY OF COLUMBUS, FRANKLIN COUNTY, OHIO

Date: August 30, 2004

Scale: 1" = 50'

Job No: 2004-0610

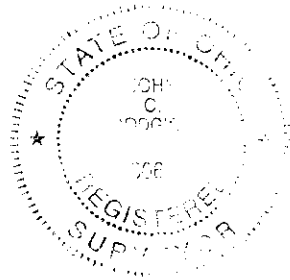

ULRICA G. GLOVER
I.N. 199906290165208
6 AC.

GARY G. GORDON
& DIANE R. MOORE
O.R. 12117F14

Parcel No.1

P.N. 010-231126

BRADLEY DAVIS
& SHIRLEY DAVIS
O.R. 32967F13
1.825 AC.

- = STONE FND.
- = MON. FND.
- = I.P. FND.
- = I.P. SET
- = MAG. NAIL FND.
- = MAG. NAIL SET
- ▲ = R.R. SPK. FND.
- △ = R.R. SPK. SET
- ◆ = P.K. NAIL FND.

RECEIVED

SEP 07 2004


Franklin County Engineer
Dean C. Ringle, P.E., P.S.

I.P.S Set are 13/16 I.D. Iron
pipe W/ cap inscribed EMHT INC

BASIS OF BEARINGS: The bearings are based on the Ohio State
Plane Coordination System - South Zone per NAD83. Control
for bearings was from coordinates of monuments Frank 64
and Frank 164, as established by the Franklin County
Engineering Department, a portion of the centerline of Sunbury
Road bears N05°02'32"W.



GRAPHIC SCALE
(IN FEET)

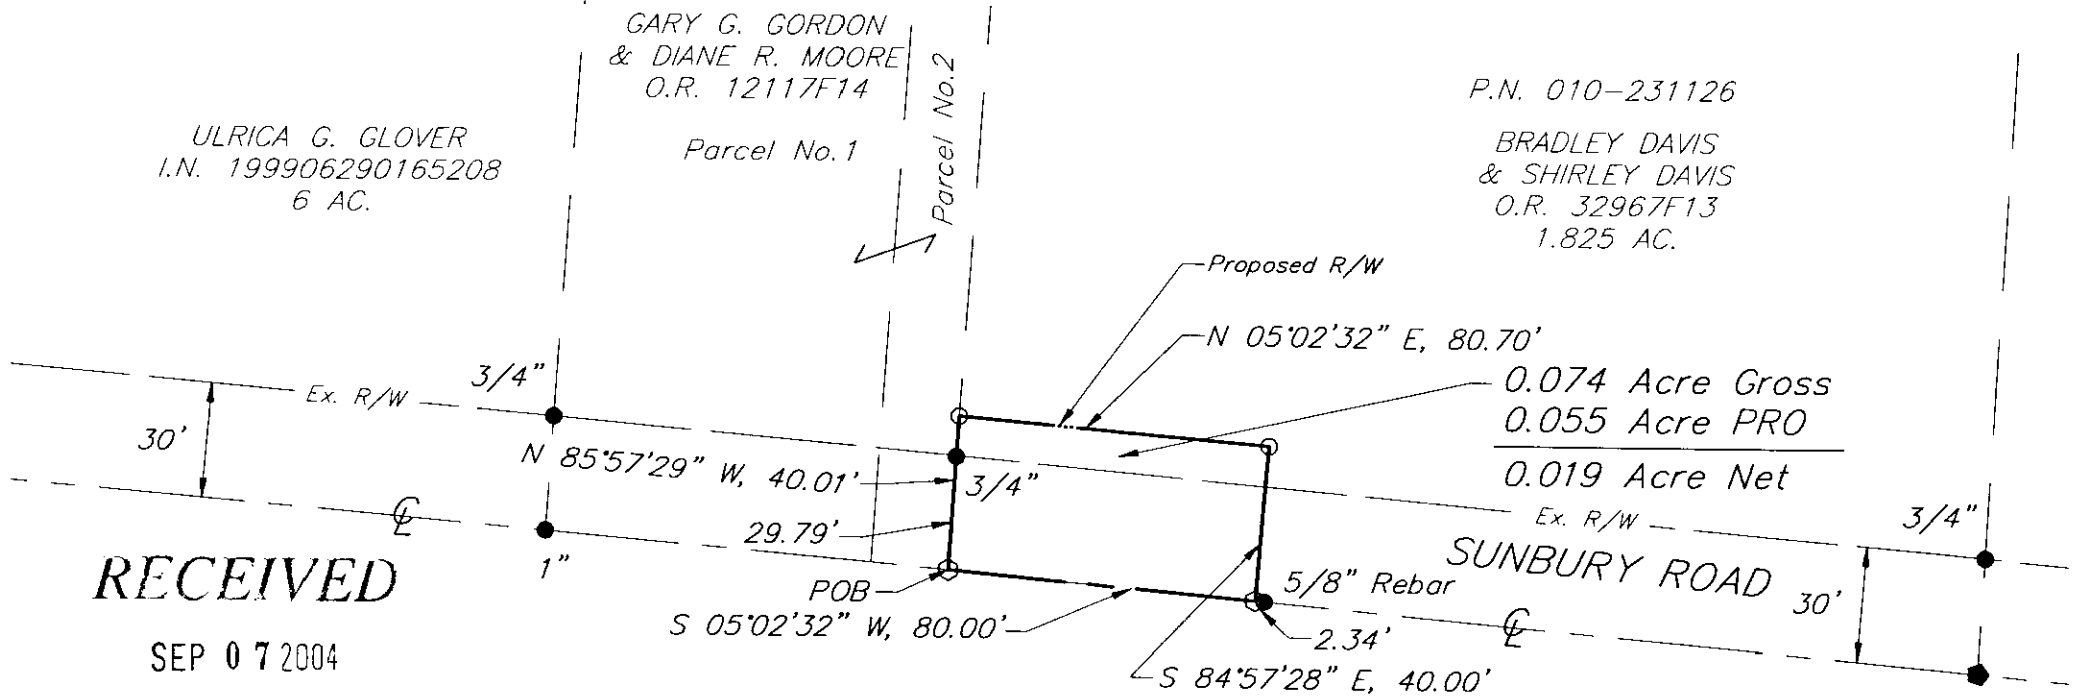

09/07/04

By John C. D...
Professional Surveyor No. 8069

I:\CMP\DATA\HIGHWAY\PROJECT\20040610\DMC\RWAGREAGE-02\DMC\LEGAL LANDS - 2 AREAS - 40610\DRW - 40610\KCL - PLOTTED BY: CBASKIN - TUESDAY, SEP 7 2004 - 3:03:57 PM