



ENGINEERS, SURVEYORS, PLANNERS, SCIENTISTS

EVANS, MECHWART, HAMBLETON & TILTON, INC.
170 MILL STREET, GAHANNA, OHIO 43230
TELEPHONE (614) 471-5150 - FACSIMILE (614) 471-9286


SURVEY OF ACREAGE PARCEL SECTION 16, TOWNSHIP 12, RANGE 21 REFUGEE LANDS CITY OF WHITEHALL, FRANKLIN COUNTY, OHIO

Date: March 26, 2004

Job No. 2004-0397

Scale: 1" = 60'

BASIS OF BEARINGS: Bearings are based the centerline of East Main Street (U.S. Route 40) being North 88° 45' 00" West and are used to denote angles only.

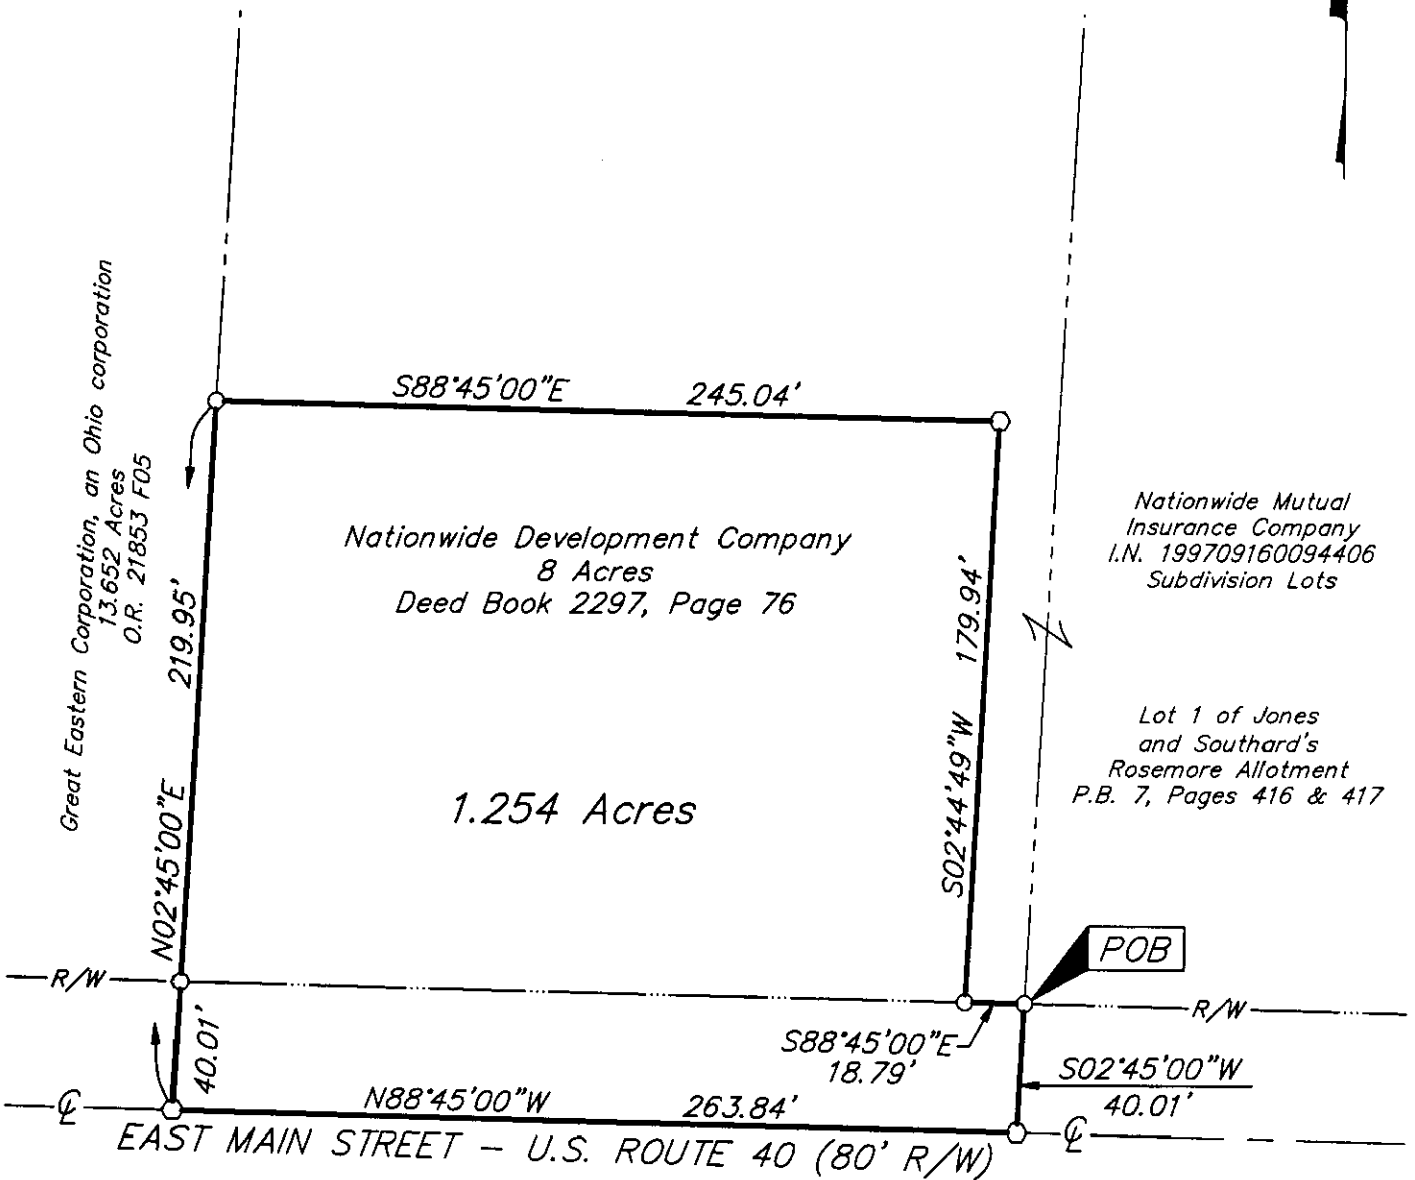


RECEIVED

JUL 15 2004

Franklin County Engineer
Dean C. Ringler, P.E., P.S.

- = STONE FND.
- = MON. FND.
- = I.P. FND.
- = I.P. SET
- = MAG. NAIL FND.
- = MAG. NAIL SET
- ▲ = R.R. SPK. FND.
- △ = R.R. SPK. SET
- ◆ = P.K. NAIL FND.

I.P. Set are 13/16" I.D. iron pipe with cap inscribed EMHT INC

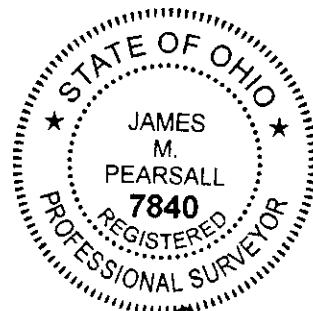

By *James M. Pearsall* 7/14/04
Professional Surveyor No. 7840
Revised June 14, 2004
Revised June 16, 2004
Revised July 14, 2004



GRAPHIC SCALE
(IN FEET)

\\CMHDATA1\SURVEY\PROJECT\20040397\DWG\40397BV.DWG-LEGAL PORTRAIT - NO XREFS - PLOTTED BY: BSMITH - WEDNESDAY, JUL 14 2004 - 9:55:46 AM