
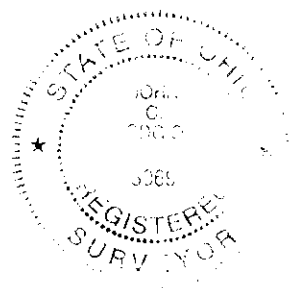


- = STONE FND.
- = MON. FND.
- = I.P. FND.
- = I.P. SET
- = MAG. NAIL FND.
- = MAG. NAIL SET
- ▲ = R.R. SPK. FND.
- △ = R.R. SPK. SET
- ◆ = P.K. NAIL FND.

I.P. Set are 13/16" I.D. iron pipe with cap inscribed EMHT INC

**BASIS OF BEARINGS:** Bearings are based on the Ohio State Plane Coordinate System per NAD83. Control for bearings was from coordinates of monuments FRANK 32 & FRANK 132, having a bearing of South 57°12'05" East, as established by the Franklin County Engineering Department.

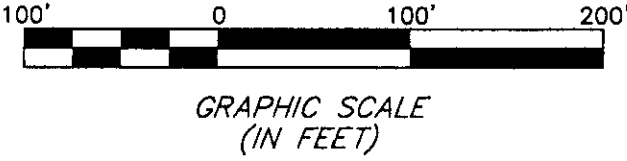

09/01/04  
By John C. Dady  
Professional Surveyor No. 8069

\\CM\DATA\PROJECT\2004\1382\DWG\11X17 PORTRAIT HP5000 - NO XREFS - PLOTTED BY: JBUSHBY - MONDAY, AUG 30 2004 - 9:24:24 AM