Myers Surveying Company, Inc.

2740 East Main Street, Columbus 43209 (Bexley), Ohio
614-235-8677 FAX: 614-235-4559

A Boundary Survey prepared for and certified to:
Bud C. Hatfield

Legal Description: Situated in Ohio, County of Franklin, City of Columbus, Being Part of 24.5215 and 12.1467 Acres in Virginia Military Survey #1462

Applicant:

Posted Address: Auto Mall Parkway & Auto Mall Drive, Columbus, Ohio

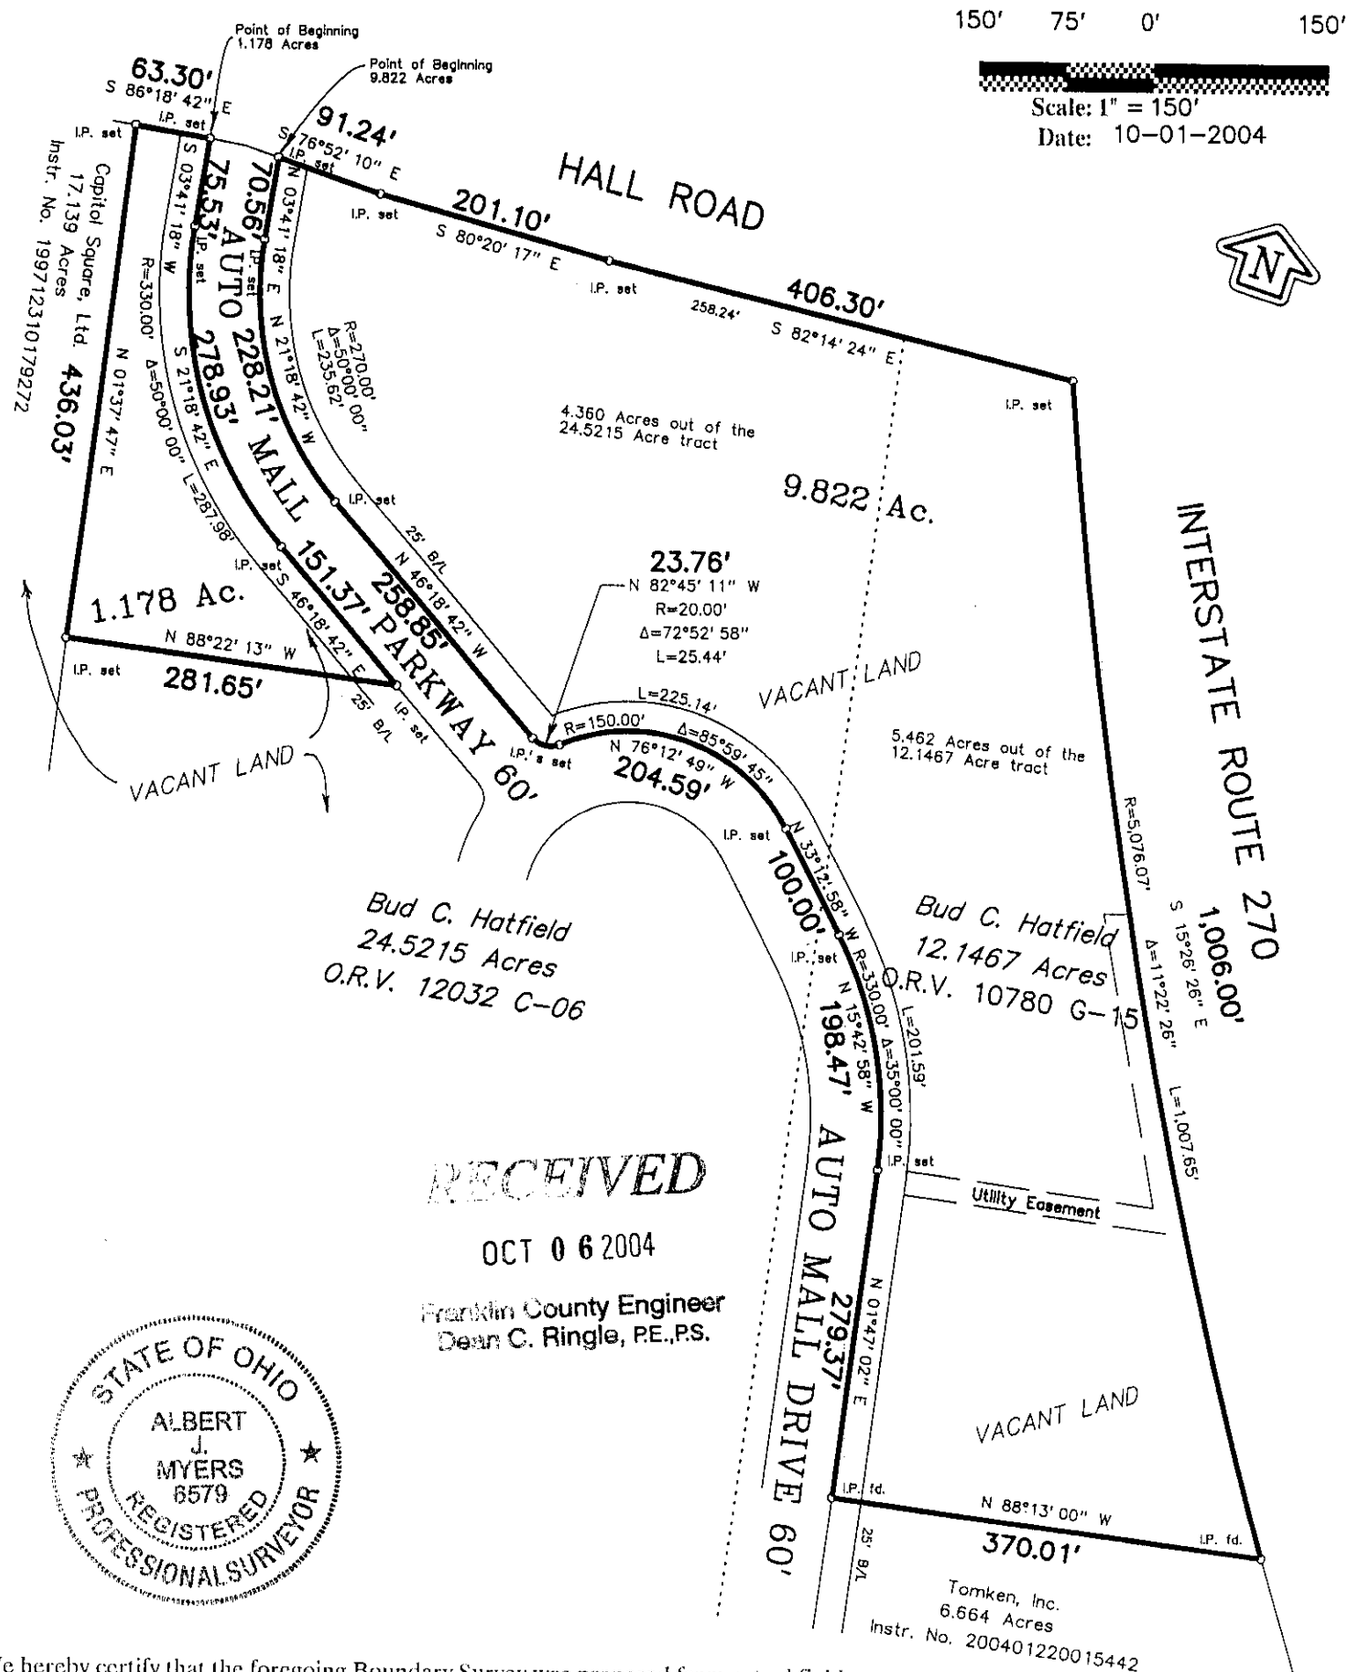

RECEIVED
OCT 0 6 2004
Franklin County Engineer
Dean C. Ringle, P.E.,P.S.

STATE OF OHIO
ALBERT J. MYERS 6579 REGISTERED PROFESSIONAL SURVEYOR

We hereby certify that the foregoing Boundary Survey was prepared from actual field measurements in accordance with Chapter 4733-37 Ohio Administrative Code. Iron pins set are 30"x1" O.D. with an orange plastic plug inscribed "P.S. 6579", unless otherwise noted. Basis of bearings is West line of the 24.5215 Acre tract held as North 01 degrees 37 minutes 47 seconds East as per Plat Book 70, Page 77

Myers Surveying Co., Inc.
By _____
Professional Surveyor

Myers Order No. - 26-12/04/03	Rec.	Field	DWG	Ltr.	Ck.