EMH&T INC.
ENGINEERS, SURVEYORS, PLANNERS, SCIENTISTS

EVANS, MECHWART, HAMBLETON & TILTON, INC.
170 MILL STREET, GAHANNA, OHIO 43230
TELEPHONE (614) 471-5150 - FACSIMILE (614) 471-9286

SURVEY OF ACREAGE PARCEL
QUARTER TWP. 4, TOWNSHIP 1, RANGE 18
UNITED STATES MILITARY LANDS
CITY OF COLUMBUS, FRANKLIN COUNTY, OHIO

Date: March 24, 2004	Job No. 2004-0355	Scale: 1" = 60'

BASIS OF BEARINGS: The bearings shown hereon are based on the east line of Casita Park Subdivision as recorded in Plat Book 17, Page 178 as being North 03° 18' 00" East.

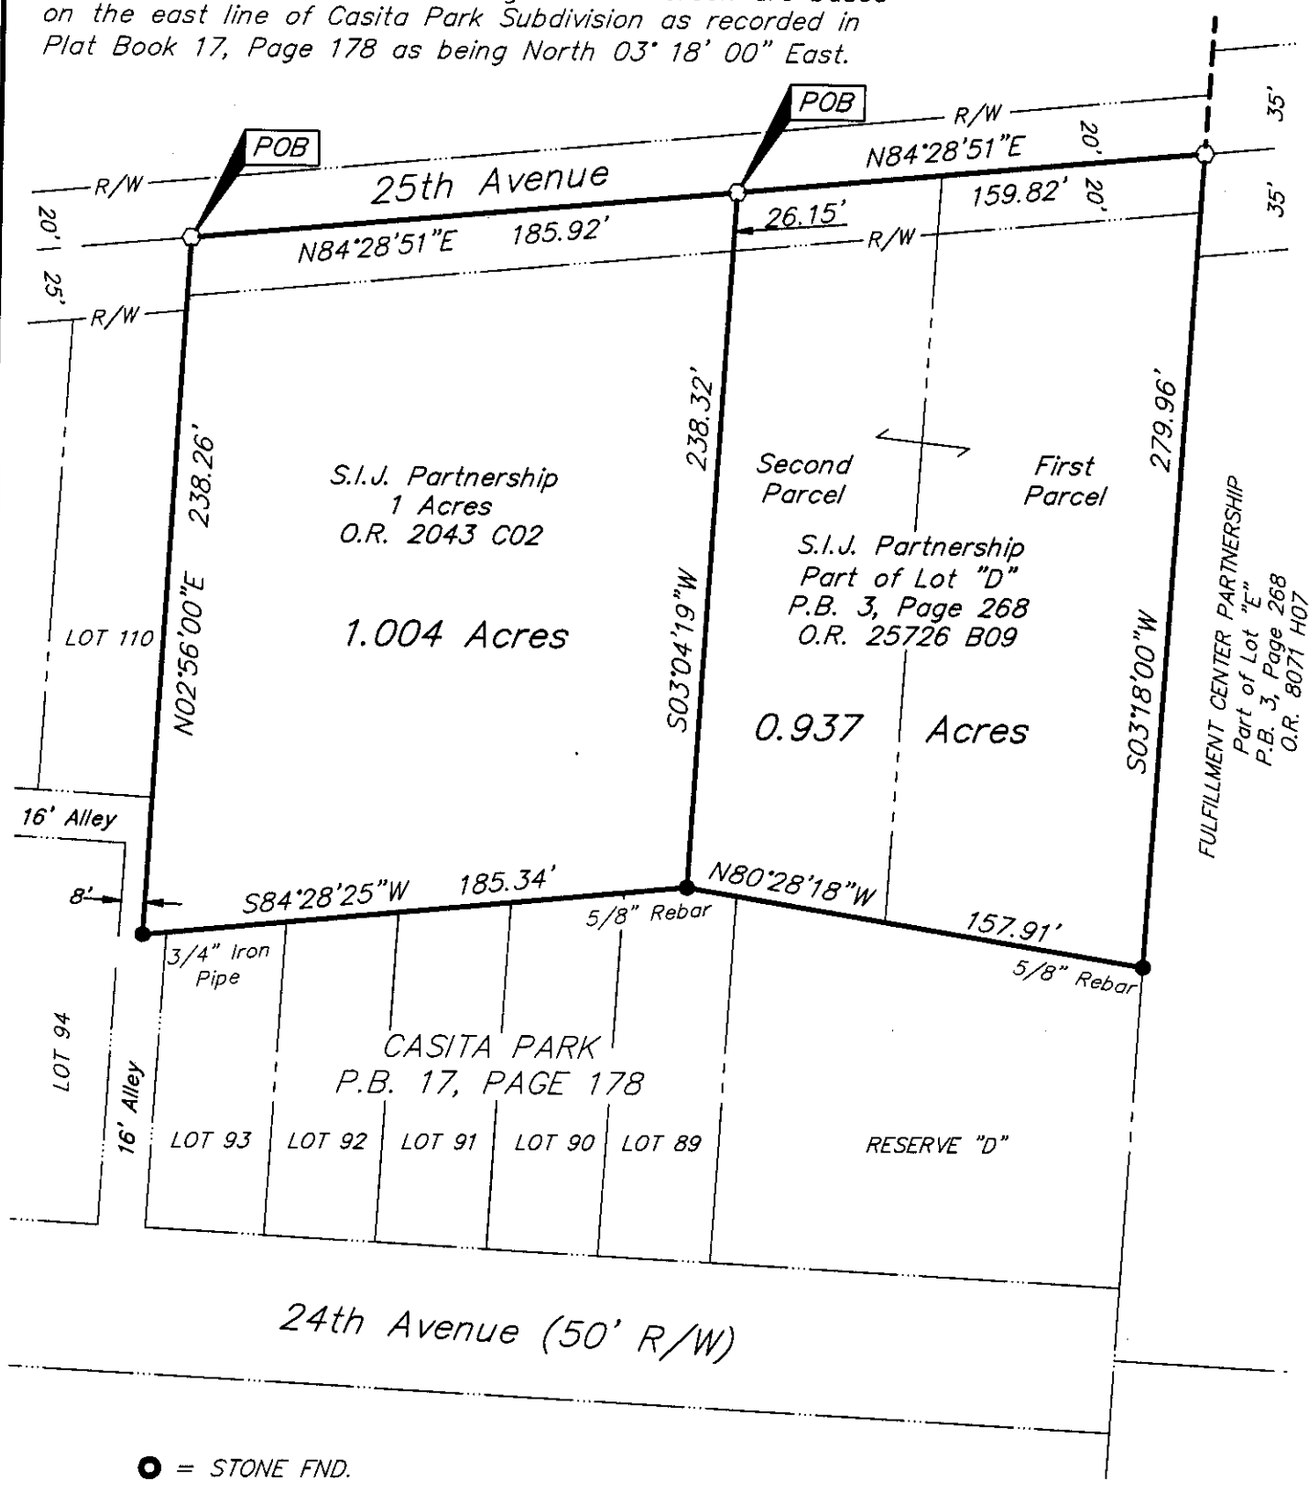

- ○ = STONE FND.
- ■ = MON. FND.
- ● = I.P. FND.
- ○ = I.P. SET
- ⬟ = MAG. NAIL FND.
- ⬡ = MAG. NAIL SET
- ▲ = R.R. SPK. FND.
- △ = R.R. SPK. SET
- ⬟ = P.K. NAIL FND.

I.P. Set are 13/16" I.D. iron pipe with cap inscribed EMHT INC

RECEIVED
OCT 26 2004
Franklin County Engineer
Dean C. Ringle, P.E., P.S.

STATE OF OHIO
JAMES M. PEARSALL
7840
REGISTERED PROFESSIONAL SURVEYOR

60' 0 60' 120'
GRAPHIC SCALE (IN FEET)

By James M Pearsall 10/26/04
Professional Surveyor No. 7840

\\CMHDATA1\SURVEY\PROJECT\20040355\DWG\40355BV1.DWG<LEGAL PORTRAIT> - NO XREFS - PLOTTED BY: JPEARSALL - TUESDAY, OCT 26 2004 - 9:12:55 AM