
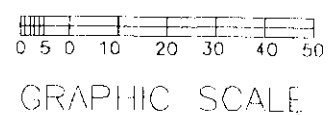



HULSART & ASSOCIATES, INC.
 2979 HEADLEY'S MILL ROAD
 PATASKALA, OHIO 43062

A LOT SPLIT PREPARED FOR
 BRETT A. INGRAM

Legal Description: Situated in the State of Ohio, County of Franklin, City of Columbus, and being Lot Number 4 of E. Sorin's Subdivision, P.B. 1, P. 286, Recorder's Office, Franklin County, Ohio.

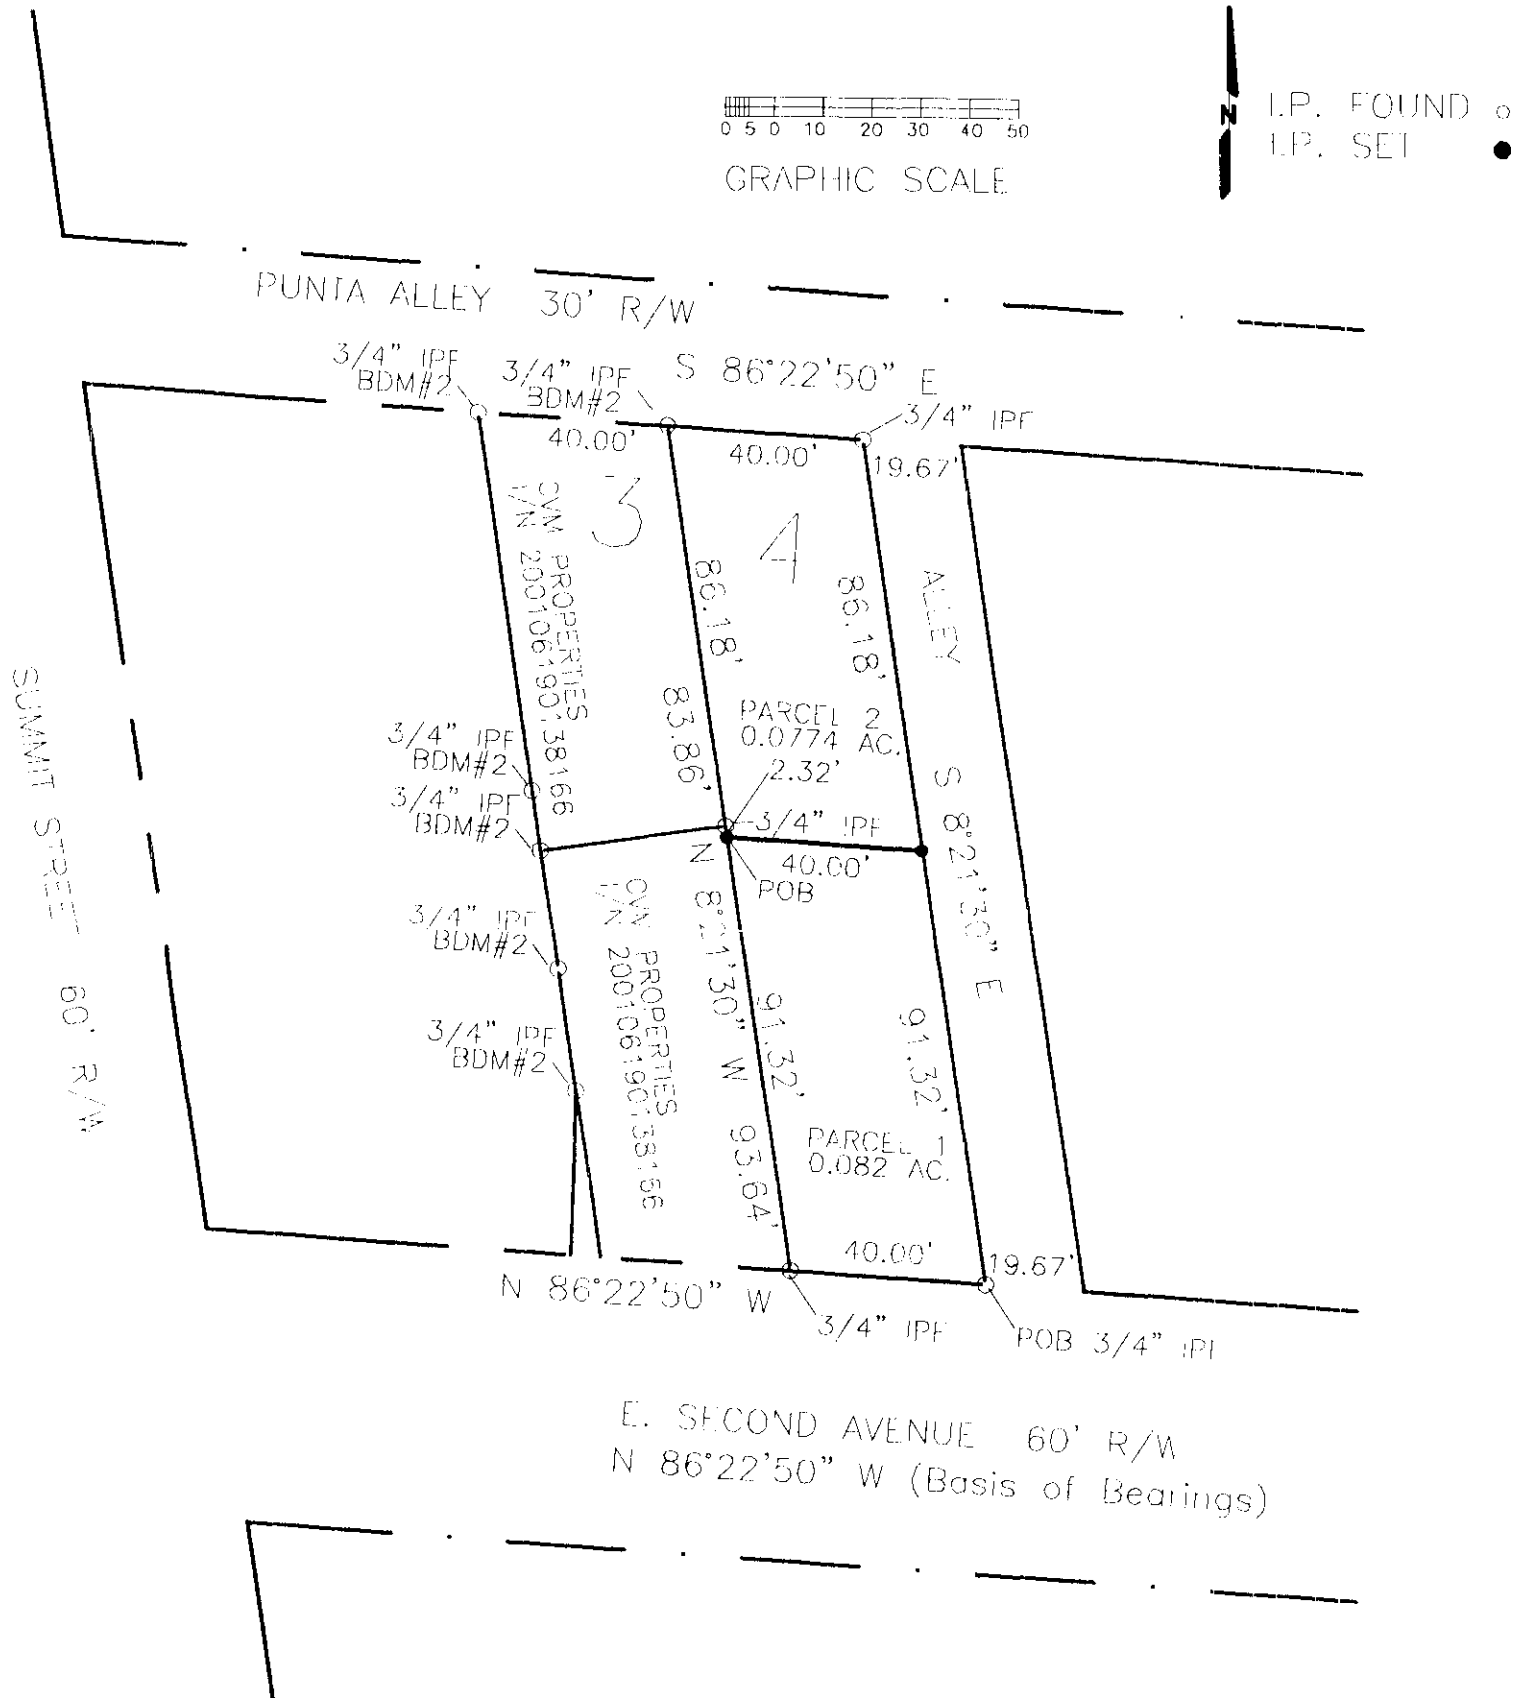

We hereby certify that the foregoing Plat of Survey was prepared from actual field measurements made on February 28, 2005, in accordance with Chapter 4733-37 Ohio Administrative Code.

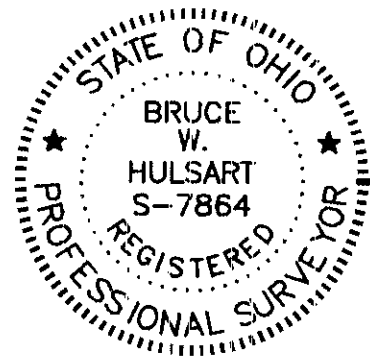

RECEIVED

MAR 05 2005

Bruce W. Hulsart 3-23-05
 REGISTERED SURVEYOR DATE

Franklin County Engineer
 Dean C. Ringle, PE, PS.

SCALE: 1"=40'