EMH&T INC.
ENGINEERS, SURVEYORS, PLANNERS, SCIENTISTS
EVANS, MECHWART, HAMBLETON & TILTON, INC.
170 MILL STREET, GAHANNA, OHIO 43230
TELEPHONE (614) 471-5150 - FACSIMILE (614) 471-9286

SURVEY OF ACREAGE PARCEL
QUARTER SECTION 1, TOWNSHIP 1, RANGE 18
UNITED STATES MILITARY LANDS
CITY OF COLUMBUS, FRANKLIN COUNTY, OHIO

010 - 103735

Date: November 8, 2004
Scale: 1" = 60'
Job No: 2004-1926

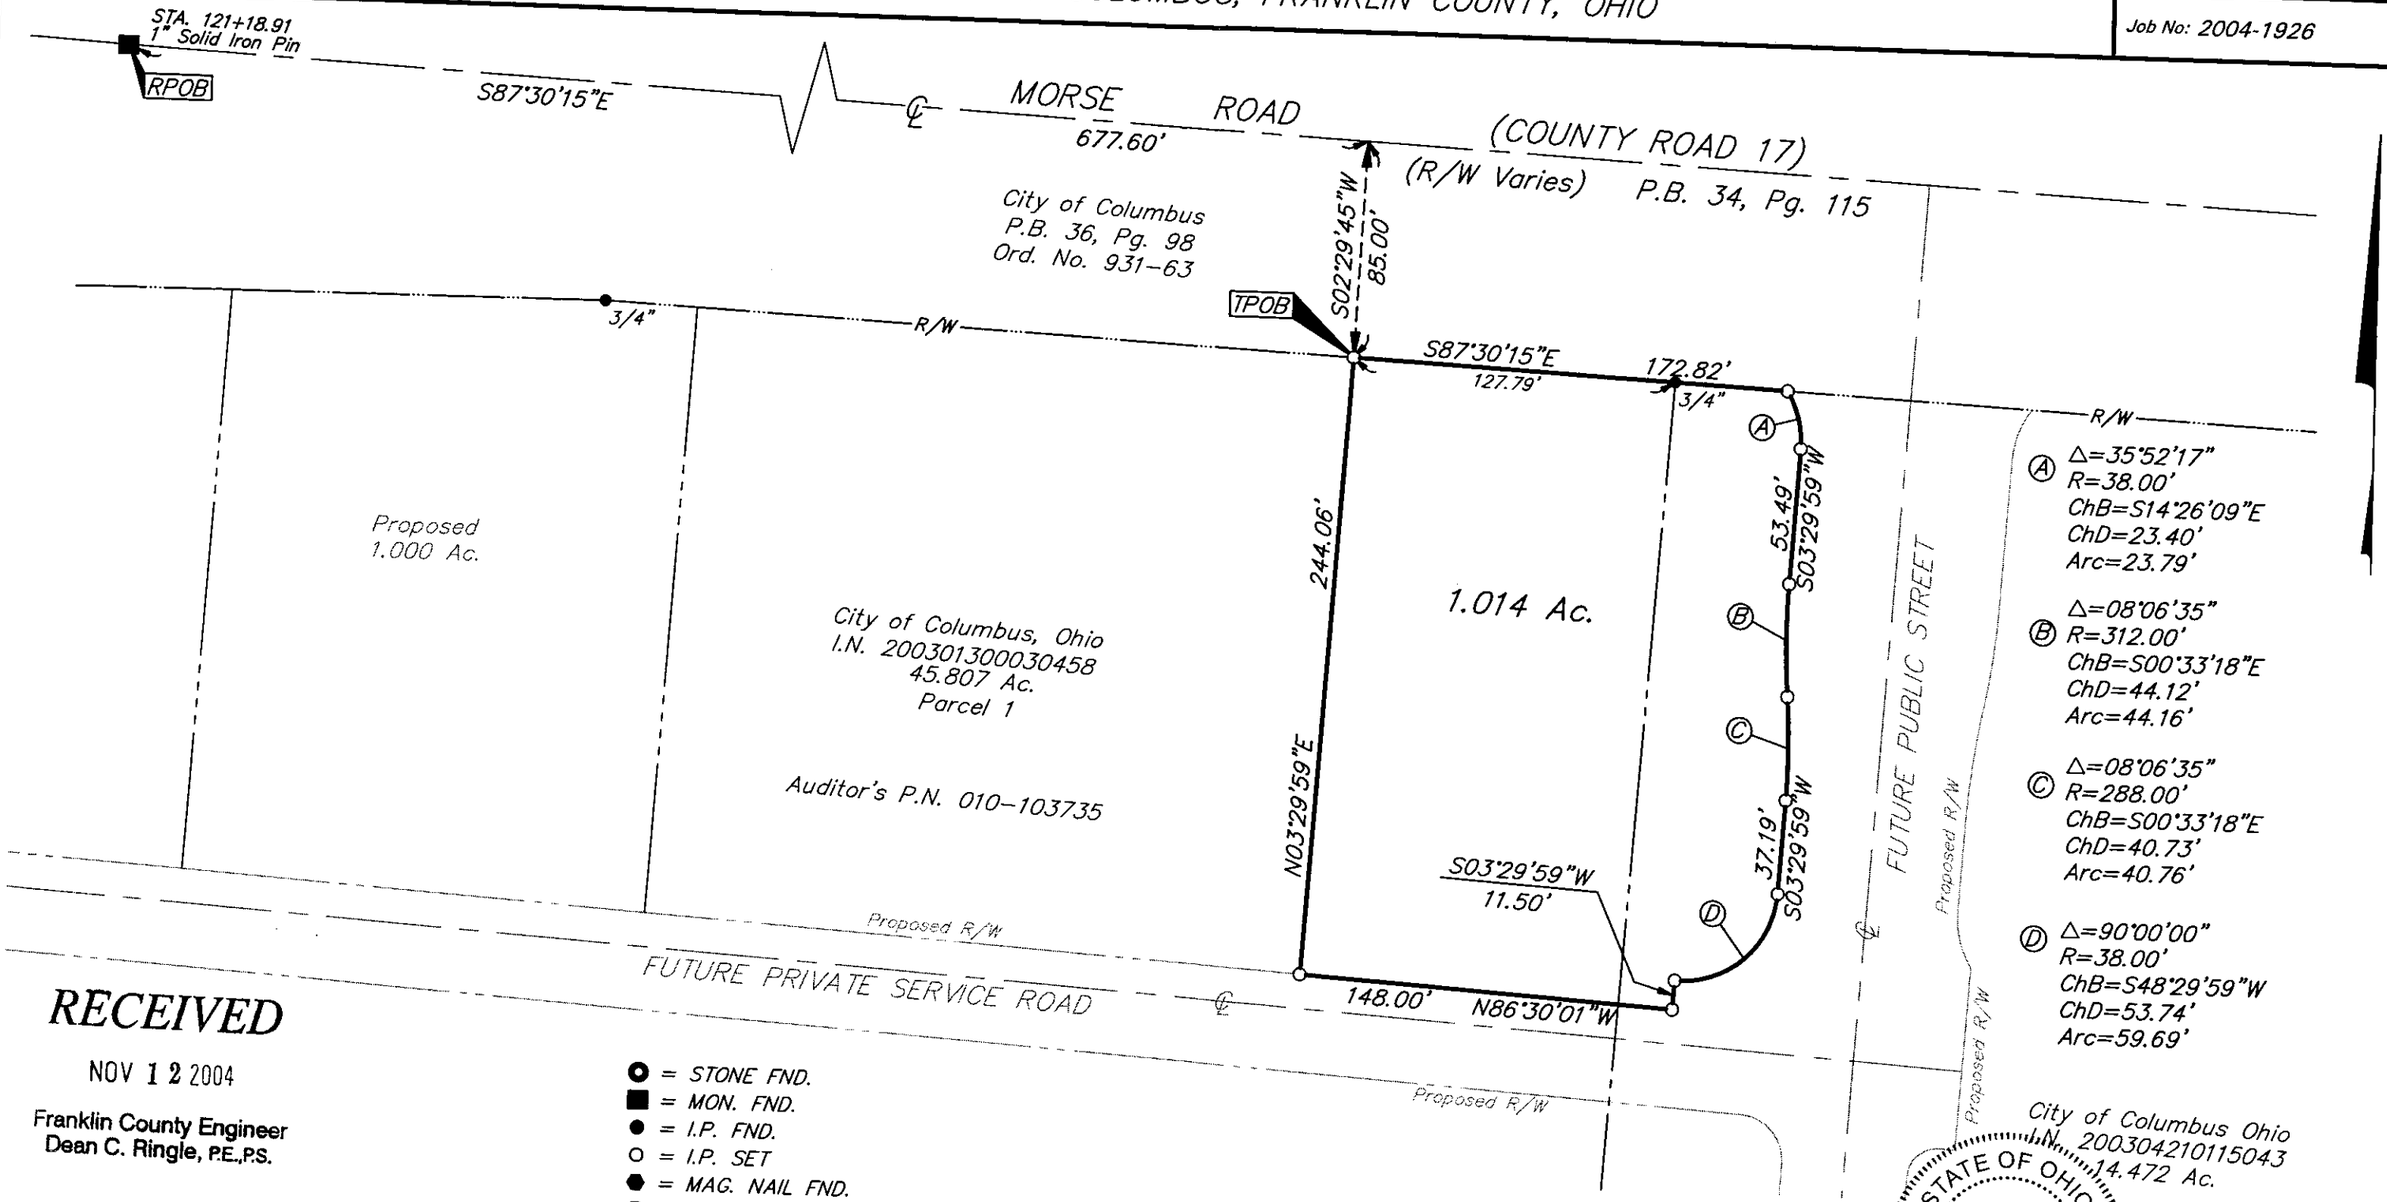

RECEIVED
NOV 12 2004
Franklin County Engineer
Dean C. Ringle, P.E.,P.S.

60' 0 60' 120'
GRAPHIC SCALE
(IN FEET)

- ○ = STONE FND.
- ■ = MON. FND.
- ● = I.P. FND.
- ○ = I.P. SET
- ⬢ = MAG. NAIL FND.
- ⬡ = MAG. NAIL SET
- ▲ = R.R. SPK. FND.
- △ = R.R. SPK. SET
- ⬟ = P.K. NAIL FND.

I.P. Set are 13/16" I.D. iron pipe with cap inscribed EMHT INC

BASIS OF BEARINGS: The bearings contained herein are based on the Ohio State Plane Coordinate System as per NAD83. Control for bearings was from coordinates for Franklin County Geodetic Survey Monuments CLARK and CLARK AZIMUTH, having a bearing of North 00° 39' 58" East, established by the Franklin County Engineering Department.

STATE OF OHIO
JAMES M. PEARSALL
7840
REGISTERED
PROFESSIONAL SURVEYOR

By James M Pearsall 11/11/04
Professional Surveyor No. 7840